Paul + Shirley RUTLEDGE

IREDELL COUNTY HEALTH DEPARTMENT - *ENVIRONMENTAL HEALTH* ☒ STATESVILLE OFFICE 704-878-5305 ☐ MOORESVILLE OFFICE 704-664-5281

IMPROVEMENT PERMIT / AUTHORIZATION TO CONSTRUCT / OPERATION PERMIT / EXISTING SYSTEM INSPECTION

1:30 pm

PERMIT # 168486 PIN # 3774-94-0473 DATE 26 September 2011

OWNER Rafael DeLeon APPLICANT: RAFAEL DeLeon PHONE: Home/Cell # (828) 803-2817 Business #

SITE ADDRESS 121 Pebble Creek Dr. Statesville OWNER / APPLICANT ADDRESS

SITE DIRECTIONS Hwy 40 W TR Shannon School Rd, TL Stewart Rock Rd TL Fullbright TR Carolina Point TR Pebble Creek

SUBDIVISION Riverwalk BLOCK / SECTION 5 LOT # 44 LOT AREA 1.272 ac. DESIGN FLOW 360 g/d L.T.A.R. 0.3 g/ft²/d

Septic Tank 1000 Gallons: STB 1012 Date 2-17-11

Pump Tank ____ Gallons: P T ____ Date ____

Pump Make ____ Model ____ Serial # ____

No. Nitrification Fields: 1 No. Lines 4 Linear Feet 300

Trench Width 36" Max. Trench Bottom Depth 36" Gravel Depth NA

☑ New System ☐ Repair ☐ Expansion System Type I II (III) IV V VI

System Description: 25% Reduction System.

Repair System Description: 25% Reduction System.

Maintenance Agreement Required ☐ YES ☑ NO

☑ GRAVITY ☐ PRESSURE

☑ Residence No. Bedrooms 3

☐ Business No. Persons ____

☐ Other No. Employees ____

☐ Slab ☑ Crawl Space

☐ Basement w/plumbing ☐ Basement w/o plumbing


Water Supply: ☑ Private ☐ Public ☐ Community

Comments / Conditions Follow contour / Keep well 100' from septic system. /


ST Has MARKER

Polylock Filter

INITIAL SITE SKETCH

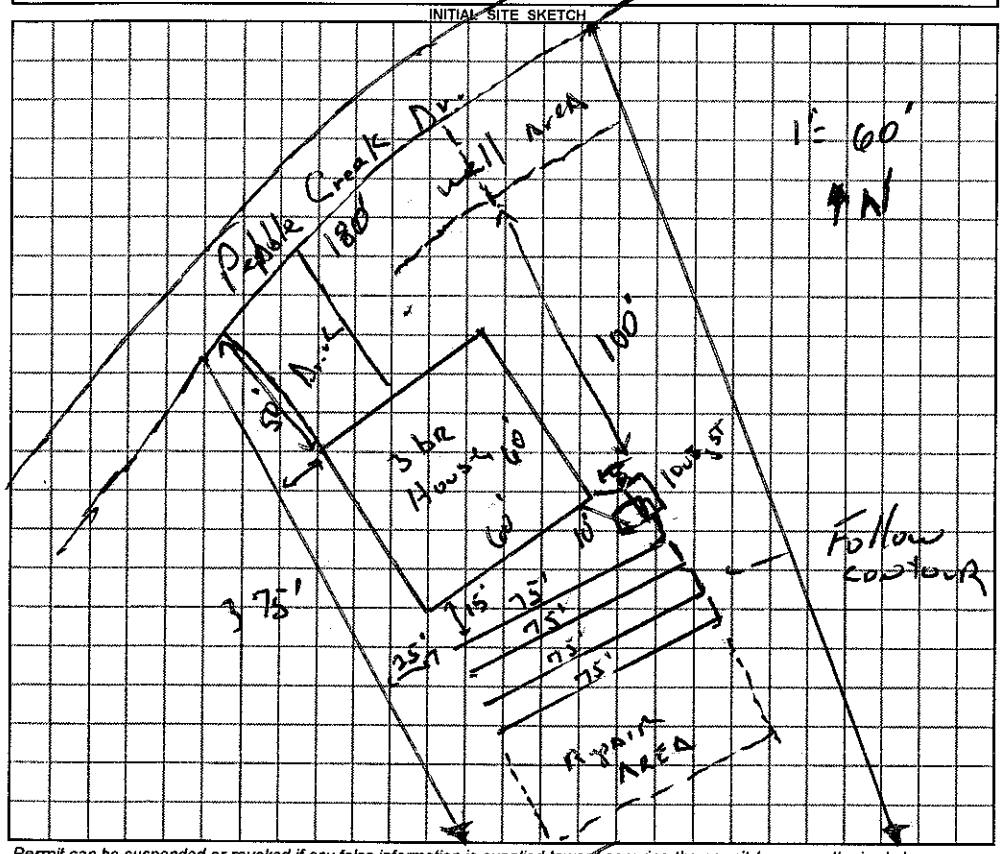

AS BUILT SKETCH

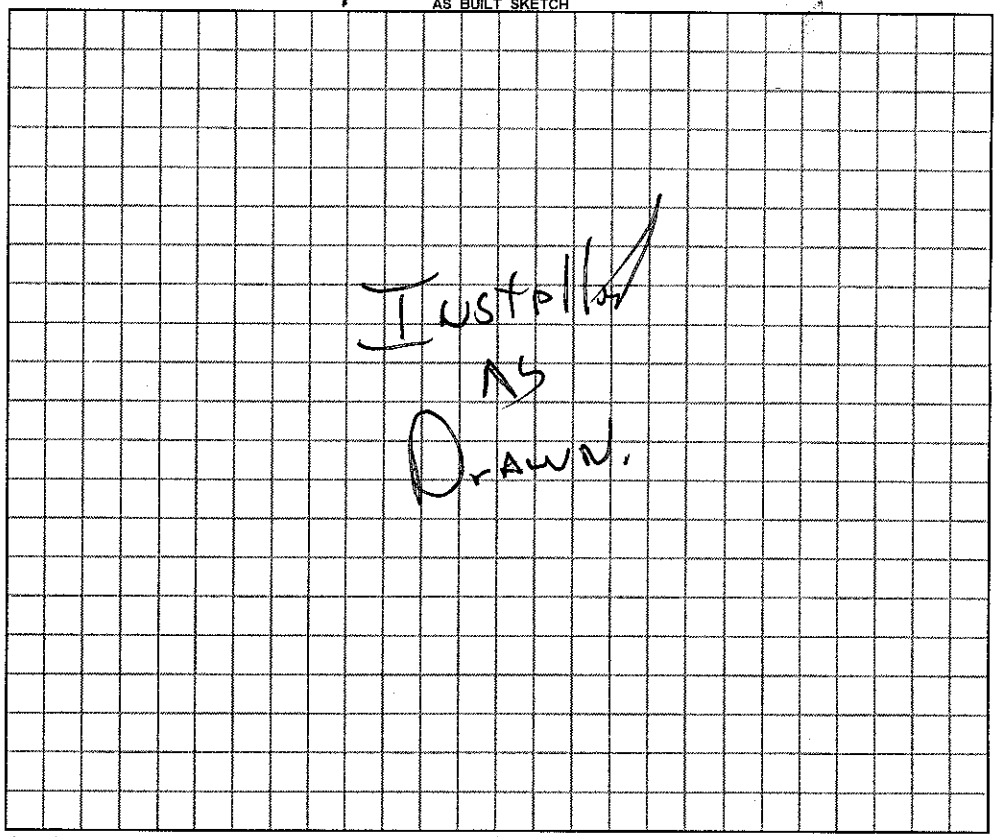

Permit can be suspended or revoked if any false information is supplied toward securing the permit / any unauthorized changes are made to the site / any unauthorized changes are made in the installation of the system.

☐ ***IMPROVEMENT PERMIT*** with plat valid without expiration. ☑ ***IMPROVEMENT PERMIT*** with plat ~~valid without expiration~~ site plan valid 60 mo. ☑ ***AUTHORIZATION TO CONSTRUCT*** valid for period equal to IMPROVEMENT PERMIT--not to exceed 60 mo.

Owner / Applicant Signature: Rafael deLeon Date 28 Sept. 11

IMPROVEMENT PERMIT by: REHS Date 26 Sept. 11

AUTHORIZATION TO CONSTRUCT by: REHS Date 26 Sept. 11

Installed by: Gunter Grading

OPERATION PERMIT by: REHS Date 30 JAN. 12

Existing System Inspected by: REHS Date ____

YOU SHOULD CONTACT A LOCATOR SERVICE PRIOR TO ANY EXCAVATION

White Copy – Environmental Health YELLOW COPY (Final) Owner / Applicant PINK COPY (Initial) Owner / Applicant