IREDELL COUNTY HEALTH DEPARTMENT

THIS PERMIT REPLACED EXPIRED PERMIT # 25276

STATESVILLE 704-878-5305 CI MOORESVILLE 704-664-5281

IMPROVEMENT PERMIT / AUTHORIZATION TO CONSTRUCT / OPERATION PERMIT / EXISTING SYSTEM INSPECTION

PERMIT# 106655 PIN# 3774-94-2671 DATE 6-7-02

OWNER OR CONTRACTOR JAMES E. MALZI PHONE Business Home 828-632-4810

ADDRESS 4161 ROCKY SPRINGS ROAD, HIDDENITE, NC 28636

LOCATION I-40 W. TR SHARON SCHOOL RD, TL STEWART ROCK RD, TL FULBRIGHT RD TR GARDNER POINT, TR PEBBLE CREEK 1ST ON LEFT

SUBDIVISION RIVERWALK BLOCK / SECTION V LOT 43 LOT AREA 1.345 ACRES SITE CLASS PS DESIGN FLOW 480 L.T.A.R. 0.30 GPD/FT²

Septic Tank: 1000 Gallons: STB 1007 Date 7-15-02
Pump Tank: 1000 Gallons: PT 274 Date 1-8-02
Pump Make: Goulds Model WE0511H Serial No. —
Nitrification Field: No Fields 1 Square Feet EQ to 1600 Linear Feet 400
No Lines FIVE Trench Width 36" Max Trench Bottom Depth 36" Gravel Depth N/A

☑ New System ☐ Repair System Type: I II III IV V VI
System Description: 25% REDUCTION, PUMP
Repair System Description: 50% REDUCTION, LOW PRESSURE
Maintenance Agreement Required: ☐ Yes ☑ No
☐ Slab ☐ Crawl Space ☑ Basement w/plumbing ☐ Basement wo/plumbing


☑ House/Mod. Home ☐ Mobile Home ☐ Business ☐ Other
No. Bedrooms 4 No. Bathrooms 2 No. Employees

Water Supply: ☑ Individual ☐ Public ☐ Community
WELL


Comments/Conditions: ① INSTALL 25% REDUCTION SYSTEM ON CONTOUR AS FLAGGED ② KEEP SYSTEM MINIMUM 100 FEET FROM WELL ③ SEE ATTACHED SHEETS FOR PUMP AND PRESSURE MANIFOLD REQUIREMENTS

Comments/Conditions: — Poly lok Filter Installed, GS Infiltrator Chambers Installed
SS, T, R. Sew Installed
Lines Inspected - 8/34/02 WOJ
Electrical + Alarm Check - okay 11/4/02 WOJ

INITIAL SITE SKETCH

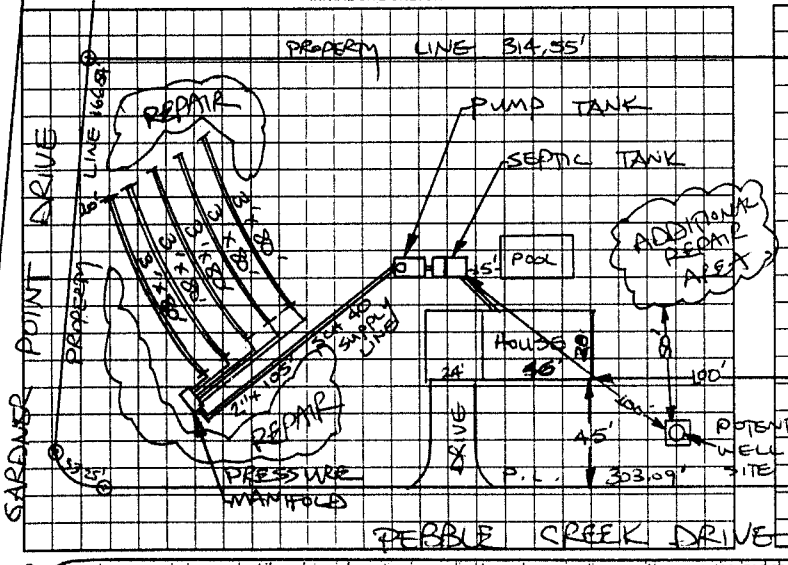

AS BUILT SKETCH

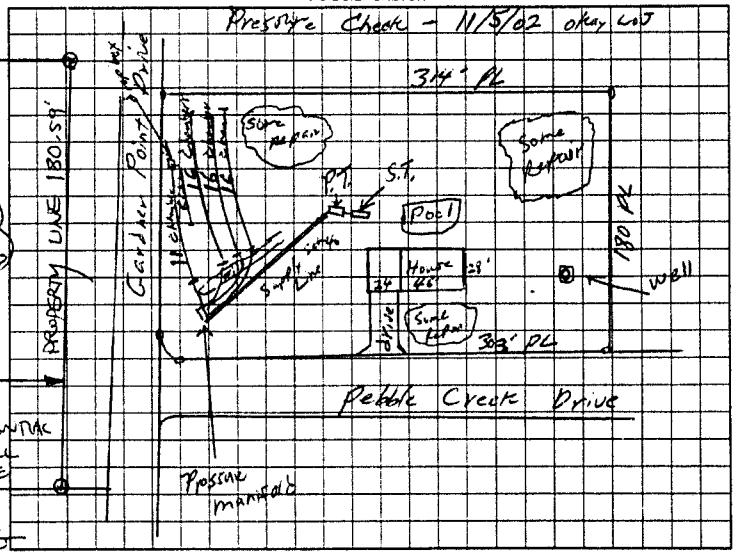

Permit can be suspended or revoked if any false information is supplied toward securing the permit/any unauthorized changes are made to the site/any unauthorized changes are made in the installation of the system. Improvement Permit with plat valid without expiration. Improvement Permit with site plan valid for sixty months. Authorization to Construct is valid for a period equal to that of Improvement Permit – not to exceed sixty months

Signed: Johnnie L. Malzi date 6/10/02 Installed by: Kelly Ward

Improvement Permit by: STEVE HENDRICK date 6-7-02 Operation Permit by: William O. Johnson date 11/5/02

Authorization to Construct by: STEVE HENDRICK date 6-7-02 Existing System Inspection by: date

HEALTH DEPT. COPY: WHITE OWNER COPY (FINAL): YELLOW OWNER COPY (INITIAL): PINK