IREDELL COUNTY HEALTH DEPARTMENT

THIS PERMIT VOIDS PREVIOUS ISSUED 9/24/97

STATESVILLE 704-878-5305 MOORESVILLE 704-664-5281

IMPROVEMENT PERMIT / AUTHORIZATION TO CONSTRUCT / OPERATION PERMIT / EXISTING SYSTEM INSPECTION

PERMIT# 078430 PIN# 3774 95 3823 DATE 9-10-99

OWNER OR CONTRACTOR JACK KING PHONE: Business Home (704) 892-0665

ADDRESS 17121 OLD STATESVILLE RD, HUNTERSVILLE, NC 28078

LOCATION I-40 W, TR SHARON SCH. RD, TL STEWART ROCK, TL FULBRIGHT, TR GARDNER POINT, 4TH LOT ON LEFT PAST RIVERCLIFF

SUBDIVISION RIVERWALK BLOCK / SECTION VIII LOT 13 LOT AREA 2.506 ACRES SITE CLASS PS DESIGN FLOW 360 L.T.A.R. 0.30 GPD/FT²

Septic Tank: 1000 Gallons; STB 312 Date 6-13-00
Pump Tank: 1000 Gallons; PT 283 Date 5-26-00
Pump Make: SQUIRT Model WE0712H Serial No J9755296
Nitrification Field: No Fields 1 Square Feet EQ. TO 1200 Linear Feet 200+
No Lines SIX Trench Width 24" Max Trench Bottom Depth 30"

✓ New System Repair System Type: I II (III) IV V VI
System Description: 50% REDUCTION PUMP
Repair System Description: LOW PRESSURE PIPE
Maintenance Agreement Required: Yes ✓ No
Depth SAND 6" Slab Crawl Space ✓ Basement w/plumbing Basement wo/plumbing


✓ House/Mod. Home No. Bedrooms 3
Mobile Home No. Bathrooms 3+
Business No. Employees
Other

Water Supply: ~~Individual~~ ☐ Public ☐ Community WELL


Comments/Conditions ① INSTALL FORTY-EIGHT (48) PPBPS PANELS IN SIX (6) EQUAL LENGTH LINES OF EIGHT (8) PANELS EACH ② KEEP SYSTEM MAXIMUM FEASIBLE DISTANCE FROM WELL (55')

Comments/Conditions ① TANKS RELOCATED AS SHOWN W/ PRIOR H.D. APPROVAL ② SEPTIC TANK W/ RISERS INSTALLED USING "ZABEL" FILTER ③ DRAINLINES INSTALLED DEEPER THAN PERMITTED ④ PRESSURE CHECK 7-21-00 ⑤ Alarm + Electrical check Okay 12-28-01 WJ

INITIAL SITE SKETCH

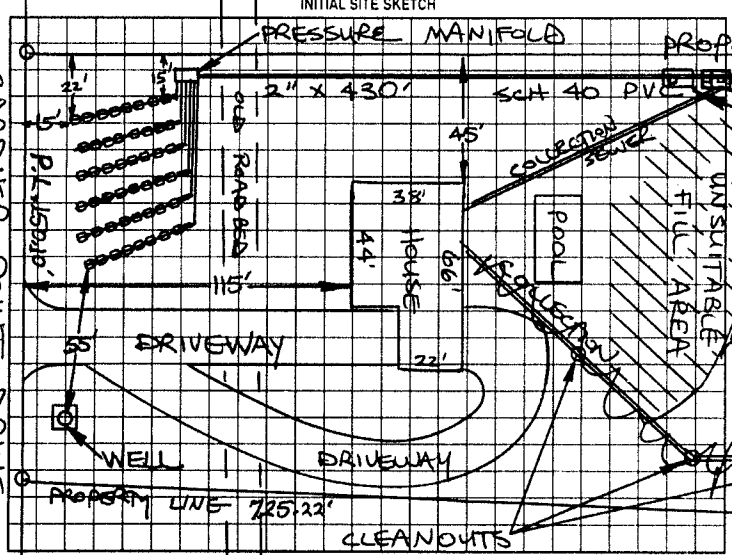

AS BUILT SKETCH

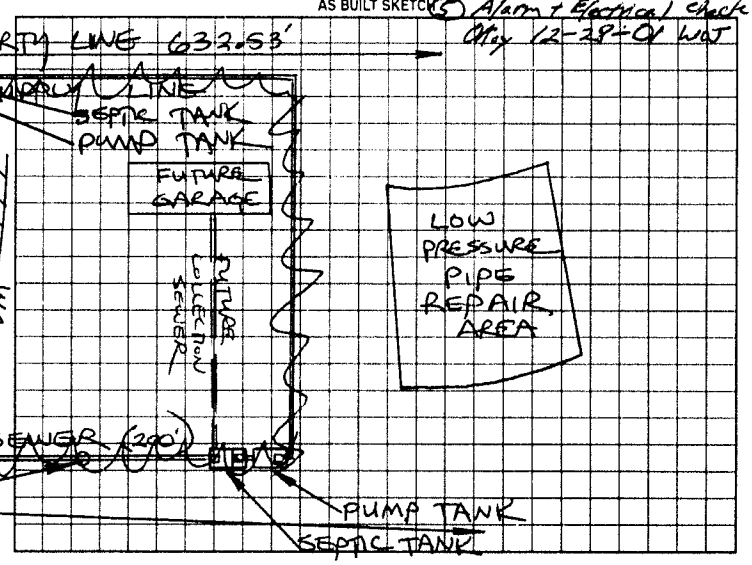

GARDNER POINT DRIVE

Permit can be suspended or revoked if any false information is supplied toward securing the permit/any unauthorized changes are made to the site/any unauthorized changes are made in the installation of the system. Improvement Permit with plat valid without expiration. Improvement Permit with site plan valid for sixty months. Authorization to Construct is valid for a period equal to that of Improvement Permit – not to exceed sixty months.

Signed: _____ date _____

Improvement Permit by: STEVE HEDRICK date 9-10-99

Authorization to Construct by: STEVE HEDRICK date 9-10-99

Installed by: F.J. ERVIN

Operation Permit by William O. Johnson date 12/28/01

Existing System Inspection by: _____ date _____

HEALTH DEPT COPY: WHITE OWNER COPY (FINAL): YELLOW OWNER COPY (INITIAL): PINK