THIS PERMIT VOIDS PREVIOUS ISSUED 9-24-97

IREDELL COUNTY HEALTH DEPARTMENT

STATESVILLE 704-878-5305 MOORESVILLE 704-664-5281

IMPROVEMENT PERMIT / AUTHORIZATION TO CONSTRUCT / OPERATION PERMIT / EXISTING SYSTEM INSPECTION

PERMIT# 067692 PIN# 3774 74 9738 DATE 7-16-98

OWNER OR CONTRACTOR KATHY & ROBERT BARRETT PHONE: Business Home (423) 581-2740

ADDRESS 1350 CRESTWAY DRIVE, MORRISTOWN, TN 37814

LOCATION I-40 W, TR SHARON SCH RD, TL STEWART ROCK, TL FULBRIGHT, LOT ON LEFT ACROSS FROM GARDNER

SUBDIVISION RIVERWALK BLOCK / SECTION 9 LOT 1 LOT AREA 4.415 ACRES SITE CLASS. P3 DESIGN FLOW 480 L.T.A.R. 0.30 GPD/FT²

Septic Tank: 1000 Gallons; STB 160 Date 2-3-99
Pump Tank: ____ Gallons; PT ____ Date ____
Pump Make: ____ Model ____ Serial No. ____
Nitrification Field: No Fields 1 Square Feet 1600 Linear Feet 533+
No Lines SIX Trench Width 36" Max Trench Bottom Depth 24" Gravel Depth 12"

[X] New System [ ] Repair System Type: I (II) III IV V VI
System Description: CONVENTIONAL GRAVITY
Repair System Description: CONV. GRAVITY
Maintenance Agreement Required: [ ] Yes [X] No

[X] House/Mod. Home No. Bedrooms 4
[ ] Mobile Home No. Bathrooms 3+
[ ] Business No. Employees ____
[ ] Other ____
[ ] Slab [ ] Crawl Space [X] Basement w/plumbing [ ] Basement wo/plumbing


Water Supply: [X] Individual [ ] Public [ ] Community WELL

POINT DRIVE


Comments:/Conditions: ① SEE ATTACHED SITE PLAN FOR PROPERTY LINES AND HOUSE LOCATION ② KEEP SYSTEM MINIMUM 100' FROM WELL ③ INSTALL LINES ON CONTOUR AS FLAGGED ON SITE.

Comments:/Conditions: TANK & UPPER THREE LINES INSPECTED 4-19-99
THIRD & FOURTH LINES INSPECTED 4-16-99

INITIAL SITE SKETCH SCALE: 1" = 30'

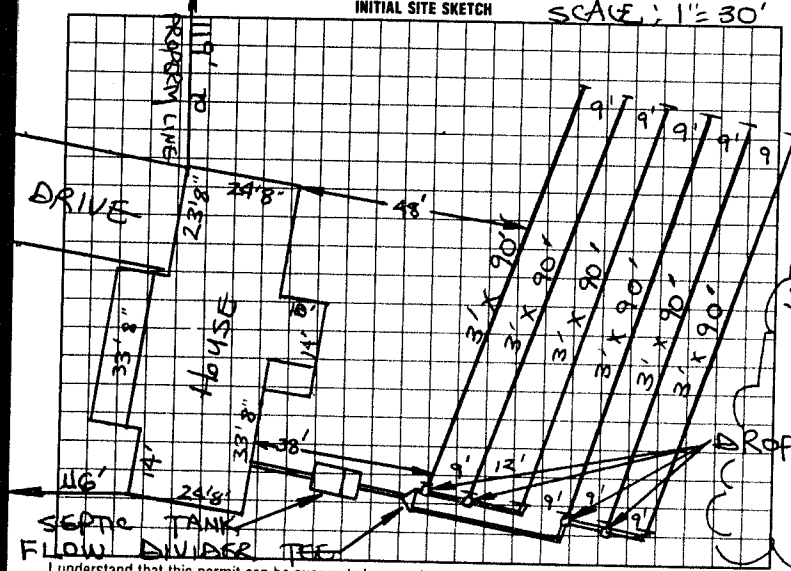

AS BUILT SKETCH

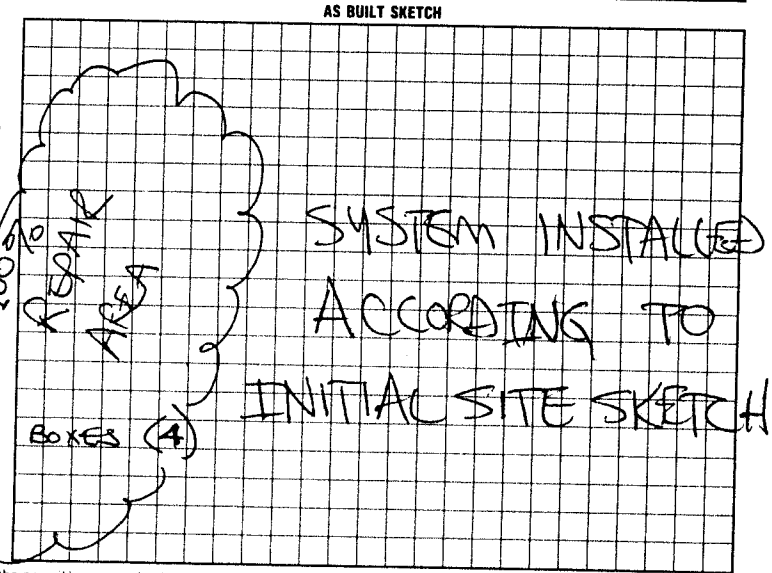

I understand that this permit can be suspended or revoked if any false information is supplied toward securing the permit/any unauthorized changes are made to the site/any unauthorized changes are made in the installation of the system. Improvement Permit with plat valid without expiration. Improvement Permit with site plan valid for sixty months. Authorization to Construct is valid for a period equal to that of Improvement Permit – not to exceed sixty months.

Signed: + Kathy J. Barrett date 7-16-98

Improvement Permit by: STEVE HEARICK date 7-16-98

Authorization to Construct by: STEVE HEARICK date 7-16-98

Installed by: BILLY BILLINGTON

Operation Permit by: STEVE HEARICK date 4-19-99

Existing System Inspection by: ____ date ____

HEALTH DEPT. COPY. WHITE INSPECTION COPY (FINAL) GREEN OWNER COPY (FINAL) YELLOW INSPECTION COPY (INITIAL) PINK OWNER COPY (INITIAL) GOLD