This Voids All Previous Permits

IREDELL COUNTY HEALTH DEPARTMENT

STATESVILLE 704-878-5305
MOORESVILLE 704-664-5281

IMPROVEMENT PERMIT / AUTHORIZATION TO CONSTRUCT / OPERATION PERMIT / EXISTING SYSTEM INSPECTION

PERMIT# 607695 PIN# TAX MAP 3774749738 DATE Apr. 13 2000

OWNER OR CONTRACTOR Doug McNeal PHONE: Business 450-1892 Home

ADDRESS 1134 4th Creek Landing Statesville

LOCATION North Sharon School Rd (L) Stewart Rock (L) Fulbright Lot on Left off Fulbright

SUBDIVISION Riverwalk BLOCK / SECTION IX LOT 4 LOT AREA 11.3Ac SITE CLASS P3 DESIGN FLOW 480 L.T.A.R. <3

Septic Tank: 1000 Gallons; STB 1012 Date 8-1-99
Pump Tank: Gallons; PT Date
Pump Make: Model Serial No.
Nitrification Field: No Fields 1 Square Feet 1600 eq ft Linear Feet 530
No Lines 4 Trench Width 36" Max Trench Bottom Depth 36" Gravel Depth 12"

☒ New System ☐ Repair System Type: I (II) III IV V VI
System Description: Conv. Gravity
Repair System Description: Same
Maintenance Agreement Required: ☐ Yes ☒ No

☒ House/Mod. Home ☐ Mobile Home ☐ Business ☐ Other
No. Bedrooms 4 No. Bathrooms 3 No. Employees


☐ Slab ☒ Crawl Space ☐ Basement w/plumbing ☐ Basement wo/plumbing

Water Supply: ☒ Individual ☐ Public ☐ Community
Well


Comments/Conditions: Install on Contour
Divert surface ditch in front of home away from septic system. 3) Locate well 100ft from septic system or max. feasible distance (50ft min)

Comments/Conditions:

INITIAL SITE SKETCH

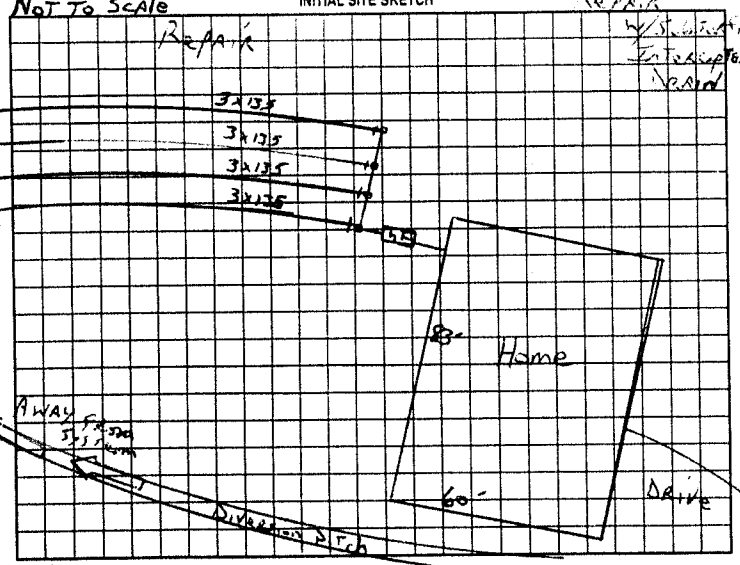

AS BUILT SKETCH

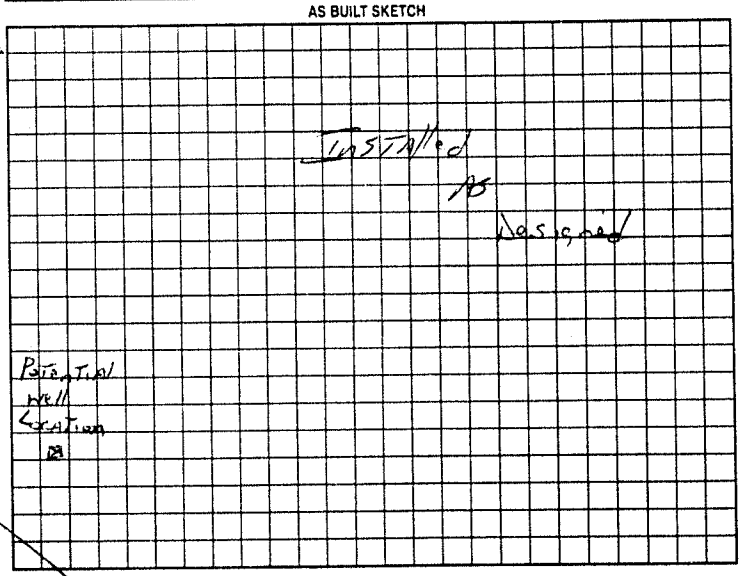

Permit can be suspended or revoked if any false information is supplied toward securing the permit/any unauthorized changes are made to the site/any unauthorized changes are made in the installation of the system. Improvement Permit with plat valid without expiration. Improvement Permit with site plan valid for sixty months. Authorization to Construct is valid for a period equal to that of Improvement Permit – not to exceed sixty months.

Signed: Doug McNeal date 5/3/00 Installed by: Doug McNeal

Improvement Permit by: L Potter date Apr. 13, 2000 Operation Permit by: L Potter date May 17 2000

Authorization to Construct by: L Potter date April 13, 2000 Existing System Inspection by: date

HEALTH DEPT. COPY WHITE OWNER COPY (FINAL) YELLOW OWNER COPY (INITIAL) PINK