IREDELL COUNTY HEALTH DEPARTMENT

STATESVILLE 704-878-5305 (C) MOORESVILLE 704-664-5281

IMPROVEMENT PERMIT / AUTHORIZATION TO CONSTRUCT / OPERATION PERMIT / EXISTING SYSTEM INSPECTION

PERMIT# 125988 PIN# 3782-92-2636 DATE 2-14-05

OWNER OR CONTRACTOR JAMES W. GOSS PHONE: Business Home 704-437-0722

ADDRESS P.O. BOX 543 CATAWBA NC 28609

LOCATION US 70 WEST, 2ND DRIVE ON LEFT BEFORE CATAWBA RIVER AT BOX # 4445

SUBDIVISION BLOCK / SECTION LOT LOT AREA 3 ACRES SITE CLASS. PS DESIGN FLOW 240 L.T.A.R. 0.30 GPD/FT²

Septic Tank: 1000 Gallons; STB 786 Date 5-12-05
Pump Tank: Gallons; PT Date
Pump Make: Model Serial No.
Nitrification Field: No Fields Square Feet 810 Linear Feet 270
No Lines THREE Trench Width 36" Max Trench Bottom Depth 36" Gravel Depth 12"

☑ New System ☐ Repair System Type: I, II, III, IV, V, VI
System Description: CONVENTIONAL, GRAVITY
Repair System Description: CONVENTIONAL, GRAVITY
Maintenance Agreement Required: ☐ Yes ☑ No


☑ House/Mod. Home No. Bedrooms 2
☐ Mobile Home No. Bathrooms
☐ Business No. Employees
☐ Other
☐ Slab ☐ Crawl Space ☑ Basement w/plumbing ☐ Basement wo/plumbing

Water Supply: ☑ Individual ☐ Public ☐ Community

Comments:/Conditions: KEEP SYSTEM MINIMUM 100 FEET FROM WELL, 10 FEET FROM PROPERTY LINE. INSTALL LINES ON CONTOUR AS FLAGGED

Comments:/Conditions: SEPTIC TANK WITH MARKER INSTALLED USING "PolyLok" FILTER

INITIAL SITE SKETCH

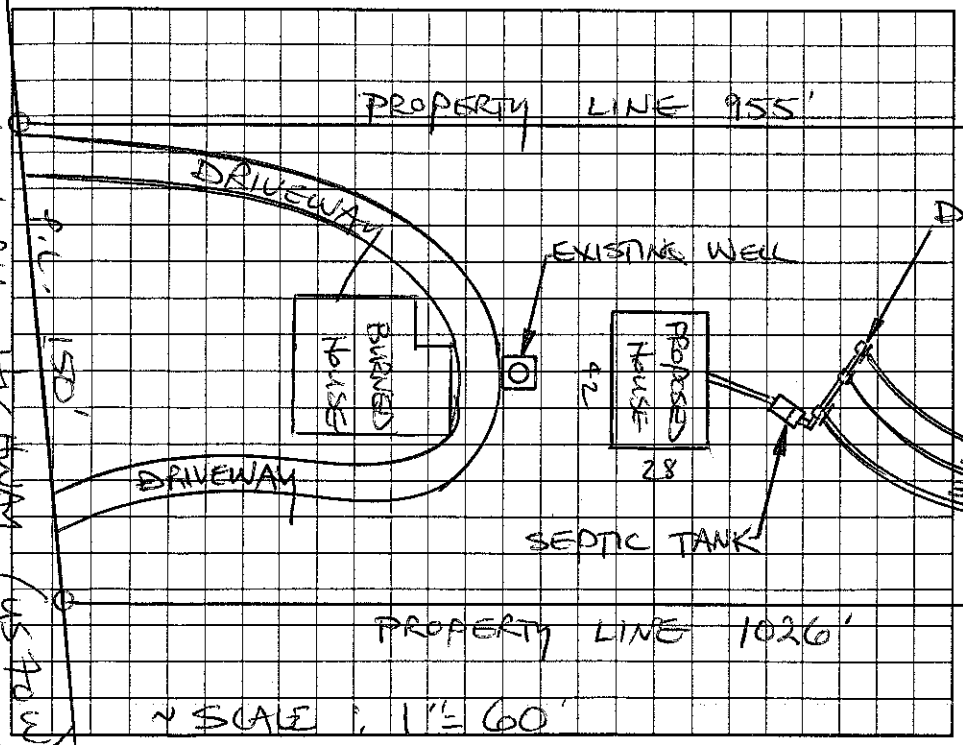

AS BUILT SKETCH

SYSTEM INSTALLED ACCORDING TO INITAL SITE SKETCH

Permit can be suspended or revoked if any false information is supplied toward securing the permit/any unauthorized changes are made to the site/any unauthorized changes are made in the installation of the system. Improvement Permit with plat valid without expiration. Improvement Permit with site plan valid for sixty months. Authorization to Construct is valid for a period equal to that of Improvement Permit – not to exceed sixty months.

Signed: James W Goss date 2-14-05 Installed by: CHARLIE BRICE

Improvement Permit by: STEVE HENDRICK date 2-14-05 Operation Permit by: STEVE HENDRICK date 9-26-05

Authorization to Construct by: STEVE HENDRICK date 2-14-05 Existing System Inspection by: date

HEALTH DEPT. COPY: WHITE OWNER COPY (FINAL): YELLOW OWNER COPY (INITIAL): PINK