This permit voids previously issued permit dated 9/11/02.

IREDELL COUNTY HEALTH DEPARTMENT

STATESVILLE 704-878-5305 MH MOORESVILLE 704-664-5281

IMPROVEMENT PERMIT / AUTHORIZATION TO CONSTRUCT / OPERATION PERMIT / EXISTING SYSTEM INSPECTION

PERMIT# 108566 PIN# 3782-92-6605 DATE 11/14/02

OWNER OR CONTRACTOR Kelly Pope PHONE: Business — Home (704) 873-9658

ADDRESS 4421 Hickory Hwy Statesville NC 28677

LOCATION Hwy 70 W/B past White Oaker on left ½ mile before river @ 4421 Hickory Hwy

SUBDIVISION — BLOCK / SECTION — LOT — LOT AREA 11.59 Ac SITE CLASS PS DESIGN FLOW 240 L T A R .40

Septic Tank: Existing Gallons: STB — Date —
Pump Tank: — Gallons: PT — Date —
Pump Make: — Model — Serial No. —
Nitrification Field: No Fields 1 Square Feet 600 Linear Feet 200
No Lines 3 Trench Width 36" Max Trench Bottom Depth 30" Gravel Depth 12"

X New System ☐ Repair System Type: I (II) III IV V VI
System Description: Gravity Conventional
Repair System Description: Gravity Conventional
Maintenance Agreement Required: ☐ Yes X No


X House/Mod. Home No. Bedrooms 4 (Added)
☐ Mobile Home No. Bathrooms 1
☐ Business No. Employees —
☐ Other —
☐ Slab ☐ Crawl Space ☐ Basement w/plumbing X Basement wo/plumbing

Water Supply: X Individual ☐ Public ☐ Community


Comments/Conditions: (1) Install Liner on Contour (3) Install flow divider tee connecting old system & New System out of Septic Tank

Comments/Conditions

INITIAL SITE SKETCH (Not to Scale)

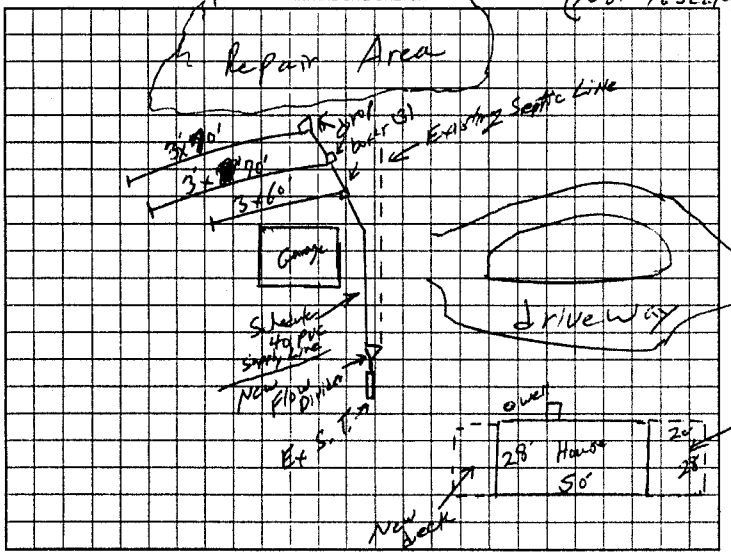

AS BUILT SKETCH

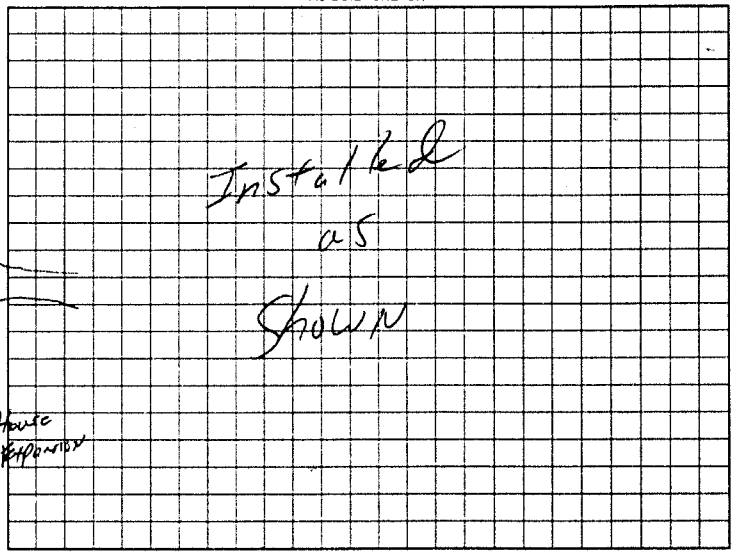

Permit can be suspended or revoked if any false information is supplied toward securing the permit/any unauthorized changes are made to the site any unauthorized changes are made in the installation of the system. Improvement Permit with plat valid without expiration. Improvement Permit with site plan valid for sixty months. Authorization to Construct is valid for a period equal to that of Improvement Permit - not to exceed sixty months

Signed: Karen H Pope date 11/14/02 Installed by: A+C Grading

Improvement Permit by: William O. Johnson date 11/14/02 Operation Permit by: William O Johnson date 11/27/02

Authorization to Construct by: William O Johnson date 11/14/02 Existing System Inspection by: — date —

HEALTH DEPT COPY WHITE OWNER COPY (FINAL) YELLOW OWNER COPY (INITIAL) PINK