This permit voids previously issued permit dated 9/11/02.

IREDELL COUNTY HEALTH DEPARTMENT

STATESVILLE 704-878-5305 MH MOORESVILLE 704-664-5281

IMPROVEMENT PERMIT / AUTHORIZATION TO CONSTRUCT / OPERATION PERMIT / EXISTING SYSTEM INSPECTION

PERMIT# 108566 PIN# 3782-92-6605 DATE 11/14/02

OWNER OR CONTRACTOR Kelly Pope PHONE: Business — Home (704) 873-9658

ADDRESS 4421 Hickory Hwy Statesville NC 28677

LOCATION Hwy 70 W, past White Oaks on Left ½ mile before river on 4421 Hickory Hwy

SUBDIVISION — BLOCK / SECTION — LOT — LOT AREA 11.59 Ac SITE CLASS PS DESIGN FLOW 240 GPD L.T.A.R. .40

Septic Tank: Existing Gallons: STB ____ Date ____

Pump Tank: ____ Gallons: PT ____ Date ____

Pump Make: ____ Model ____ Serial No. ____

Nitrification Field: No Fields 1 Square Feet 600 Linear Feet 200

No Lines 3 Trench Width 36" Max Trench Bottom Depth 30" Gravel Depth 12"

[X] New System [ ] Repair System Type: I (II) III IV V VI

System Description: Gravity Conventional

Repair System Description: Gravity Conventional

Maintenance Agreement Required: [ ] Yes [X] No

[X] House/Mod. Home No. Bedrooms 4

[ ] Mobile Home No. Bathrooms 1

[ ] Business No. Employees ____

[ ] Other ____


[ ] Slab [ ] Crawl Space [ ] Basement w/plumbing [X] Basement wo/plumbing

Water Supply: [X] Individual [ ] Public [ ] Community


Comments/Conditions: ① Install Liner on Contour ③ Install Flow divider tee connecting old system + New System out of Septic Tank

Comments/Conditions

INITIAL SITE SKETCH (Not to Scale)

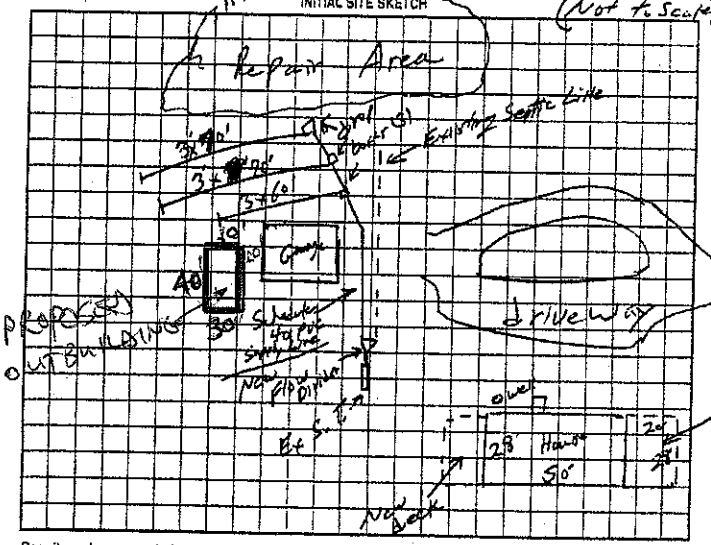

AS BUILT SKETCH

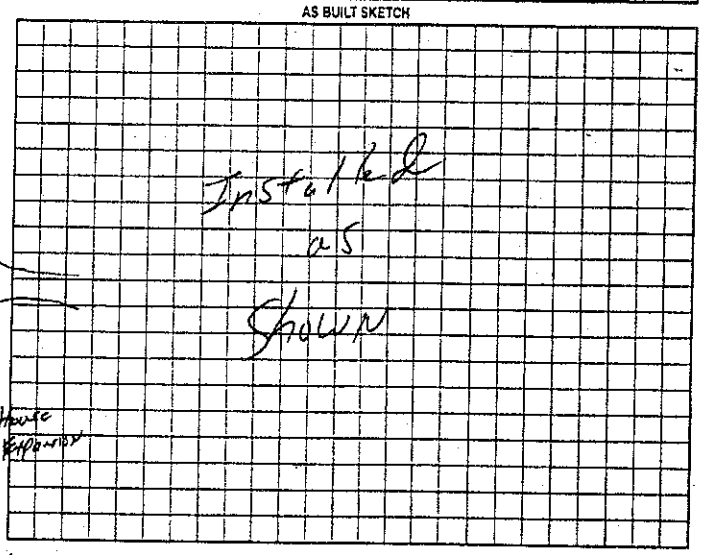

Permit can be suspended or revoked if any false information is supplied toward securing the permit/any unauthorized changes are made to the site any unauthorized changes are made in the installation of the system. Improvement Permit with plat valid without expiration. Improvement Permit with site plan valid for sixty months. Authorization to Construct is valid for a period equal to that of Improvement Permit – not to exceed sixty months.

Signed: Karen H Pope date 11/14/02

Improvement Permit by: William O Johnson date 11/14/02

Authorization to Construct by: William O Johnson date 11/14/02

Installed by: A + C Grading

Operation Permit by: William O Johnson date 11/27/02

Existing System Inspection by: ____ date ____

HEALTH DEPT COPY: WHITE OWNER COPY (FINAL): YELLOW OWNER COPY (INITIAL): PINK

Location of the proposed 30' x 40' OUTBUILDING addition does not appear to impact the existing on-site septic system.**NOTE: KEEP MINIMUM 5' FROM SYSTEM

R. STEVE HENDRICK REHS

Date: AUGUST 22, 2011

ICHD-Environmental Health Division