IREDELL COUNTY HEALTH DEPARTMENT

STATESVILLE 704-878-5305 — MOORESVILLE 704-664-5281

IMPROVEMENT PERMIT / AUTHORIZATION TO CONSTRUCT / OPERATION PERMIT / EXISTING SYSTEM INSPECTION

PERMIT# Repair PIN# _____ DATE Apr. 18 2000

OWNER OR CONTRACTOR Joe Moose PHONE: Business 878-3417 Home _____

ADDRESS 2507 Island Ford Road Statesville

LOCATION Nth Sharon Sch. Rd (L) Island Ford Rd @ Sharon Market ~1.4 mile on Left down hill

SUBDIVISION _____ BLOCK / SECTION _____ LOT _____ LOT AREA .59 ac SITE CLASS _____ DESIGN FLOW 360 L.T.A.R. .3

Septic Tank: 1000 Existing Gallons; STB _____ Date _____

Pump Tank: _____ Gallons; PT _____ Date _____

Pump Make: _____ Model _____ Serial No. _____

Nitrification Field: No Fields 1 Square Feet 1200 Linear Feet 400

No Lines 4 Trench Width 36" Max Trench Bottom Depth 36" Gravel Depth 12"

☐ New System ☒ Repair System Type: I (II) III. IV. V. VI

System Description: Gravity Conventional

Repair System Description: Same

Maintenance Agreement Required: ☐ Yes ☒ No

☒ House/Mod. Home ☐ Mobile Home ☐ Business ☐ Other

No. Bedrooms 3 No. Bathrooms 2 No. Employees _____


☐ Slab ☒ Crawl Space ☐ Basement w/plumbing ☐ Basement wo/plumbing

Water Supply: ☒ Individual ☐ Public ☐ Community WELL

Comments/Conditions: Begin Septic Lines as Flagged Install on Contour May Use Distribution box w/speed levels for equal distribution Abandon old Septic Field. Inspect outlet Baffel Replace if needed Original Permit under Thomas Martin '87

Comments/Conditions.

INITIAL SITE SKETCH

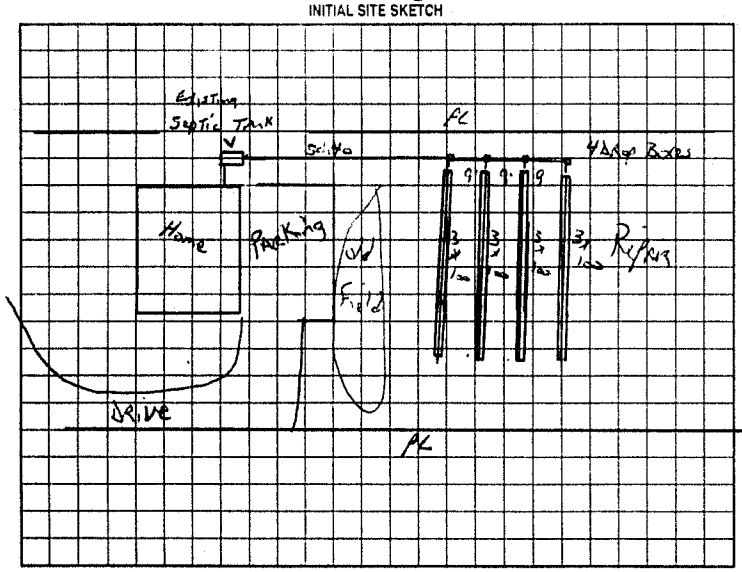

AS BUILT SKETCH

System installed as shown

Permit can be suspended or revoked if any false information is supplied toward securing the permit/any unauthorized changes are made to the site/any unauthorized changes are made in the installation of the system. Improvement Permit with plat valid without expiration. Improvement Permit with site plan valid for sixty months. Authorization to Construct is valid for a period equal to that of Improvement Permit – not to exceed sixty months.

Signed: Joe E. Moose date 4-18-00 Installed by: Craig Thompson

Improvement Permit by: Jc Potter date Apr. 18 2000 Operation Permit by: Jc Potter date 8 June 2000

Authorization to Construct by: Jc Potter date Apr. 18 2000 Existing System Inspection by: _____ date _____

HEALTH DEPT. COPY. WHITE OWNER COPY (FINAL). YELLOW OWNER COPY (INITIAL). PINK