IREDELL COUNTY HEALTH DEPARTMENT

Statesville Office (704) 878-5305 Mooresville Office (704) 660-3625 PERMIT # 205939

IMPROVEMENT PERMIT / AUTHORIZATION TO CONSTRUCT / OPERATION PERMIT / EXISTING SYSTEM

PIN # 3783446776

APPLICANT: Martin Hendricks APPLICANT ADDRESS: 346 New Sterling Rd Stony Point NC 28678

SITE ADDRESS: 413 Walnut Tree Rd Statesville NC 28625 PHONE: 704-402-3933 ALT. PHONE: N/A

SITE DIRECTIONS: 40 W to Sharon School Rd T/R then T/L on Walnut Tree Rd House on left

SUBDIVISION: Lookout Shoals Dam Tract SECTION: N/A LOT # TR3414-05 LOT AREA: 5.153 ac DESIGN FLOW: 240 L.T.A.R.: EX

Septic Tank EX (gal) STB Date

Pump Tank (gal) PT Date

Pump Make Model Serial #

Nitrification Fields EX # Lines EX Linear Ft: EX

Trench Width EX Max. Trench Bottom Depth EX Gravel Depth EX

☐ New System ☐ Repair ☐ Expansion System Type: I ☒ II III IV V VI

System Description: Existing

Repair System Description:

Maintenance Agreement Required: ☐ YES ☒ NO

☑ GRAVITY ☐ PRESSURE

☒ Residence ☐ Business ☐ Other ☐ Slab ☐ Basement w/plumbing ☐ Basement w/o plumbing


No. Bedrooms 2 No. Persons 4 No. Employees Crawl Space

Water Supply: ☒ Private ☐ Public ☐ Community

Comments / Conditions: All building foundations must be 35' from any part of STS.

INITIAL SITE SKETCH

AS BUILT SKETCH

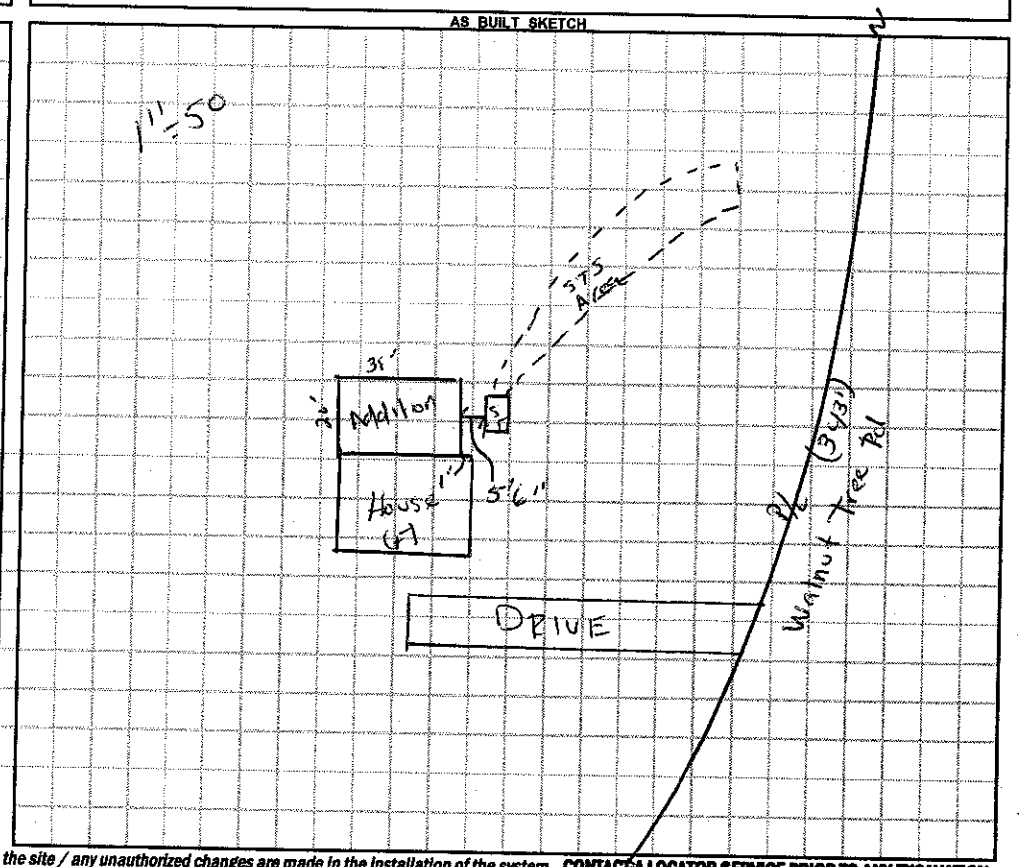

Permit can be suspended or revoked if any false information is supplied toward securing the permit / any unauthorized changes are made to the site / any unauthorized changes are made in the installation of the system. **CONTACT A LOCATOR SERVICE PRIOR TO ANY EXCAVATION**

☐ **IMPROVEMENT PERMIT** *with plat valid without expiration.* ☐ **IMPROVEMENT PERMIT** *with site plan valid for 60 mos.* ☐ **AUTHORIZATION TO CONSTRUCT** *valid for period equal to IMPROVEMENT PERMIT--not to exceed 60 mo.*

Owner / Applicant Signature: Martin Hendricks Date: 10-26-14 Installed by:

IMPROVEMENT PERMIT by: Date: OPERATION PERMIT by: Date:

AUTHORIZATION TO CONSTRUCT by: Date: Existing System Inspected by: Date: 10/01/14

Health Dept. Copy - WHITE Applicant (Final Approval) - YELLOW Applicant (Conditional Approval) - PINK