IREDELL COUNTY HEALTH DEPARTMENT

Statesville Office (704) 878-5305 Mooresville Office (704) 660-3625 PERMIT # 217840

IMPROVEMENT PERMIT / AUTHORIZATION TO CONSTRUCT / OPERATION PERMIT / EXISTING SYSTEM

PIN # 3783465147

APPLICANT: Hendricks Builders APPLICANT ADDRESS: 346 New Sterling Rd.

SITE ADDRESS: 374 Lookout Dam Rd, Statesville PHONE: 704-902-0574 ALT. PHONE: N/A


SITE DIRECTIONS: Hwy 70W TR Sharon School Rd. TL Lookout Dam Rd. Property ~2miles on Right

SUBDIVISION: River Rock Farms SECTION: N/A LOT # TRACT 10 LOT AREA: 4.14 acres DESIGN FLOW: 240gpd L.T.A.R.: 0.25


Septic Tank	1060 (gal)	STB	160	Date	1-20-16	☑ New System ☐ Repair ☐ Expansion System Type: I II (III) IV V VI		☑ Residence	No. Bedrooms	2	Water Supply
Pump Tank	(gal)	PT		Date		System Description: 25% Reduction		☐ Business	No. Persons	4	☑ Private
Pump Make		Model		Serial #		Repair System Description: 75% Reduction		☐ Other	No. Employees		☐ Public
# Nitrification Fields	1	# Lines	2	Linear Ft:	240	Maintenance Agreement Required: ☐ YES ☑ NO		☐ Slab	☑ Crawl Space		☐ Community
Trench Width	36"	Max. Trench Bottom Depth	36"	Gravel Depth	N/A	☑ GRAVITY ☐ PRESSURE		☐ Basement w/plumbing	☐ Basement w/o plumbing		

Comments / Conditions: IMPROVEMENTS ONLY! Submit Floor Plan prior to issuance of CA! Install a 25% Reduction system on Contour with Serial distribution & Install trench Bottom @ 36" high side

INITIAL SITE SKETCH

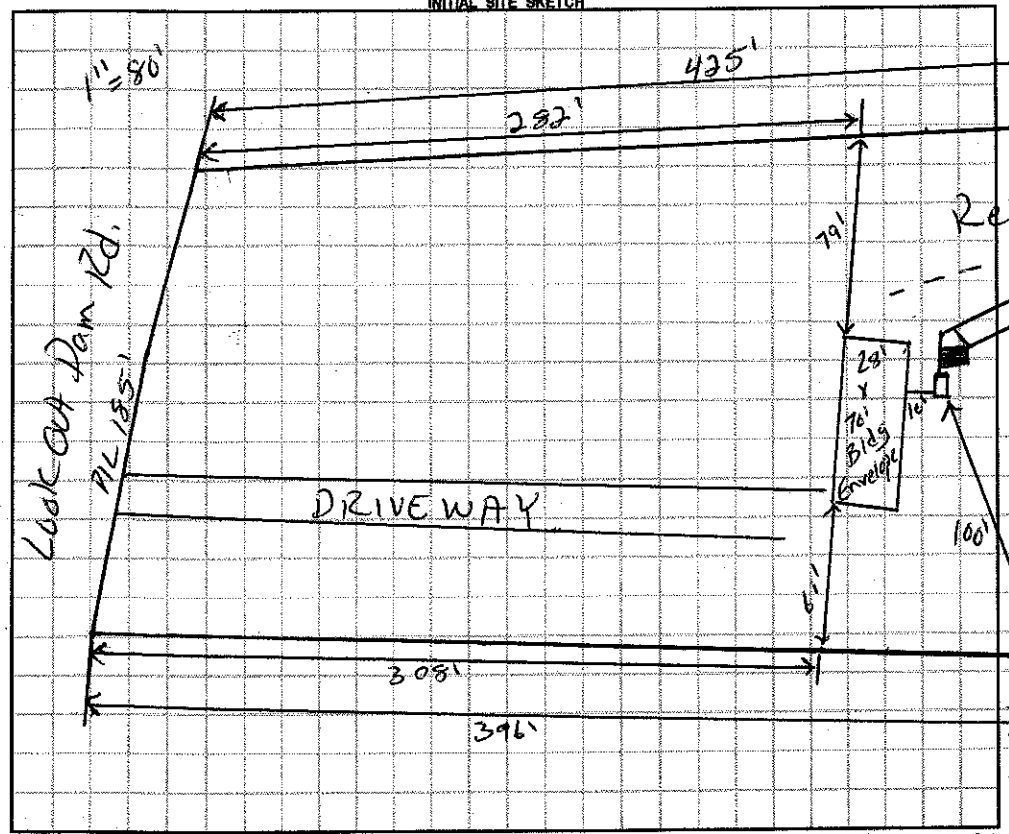

AS BUILT SKETCH

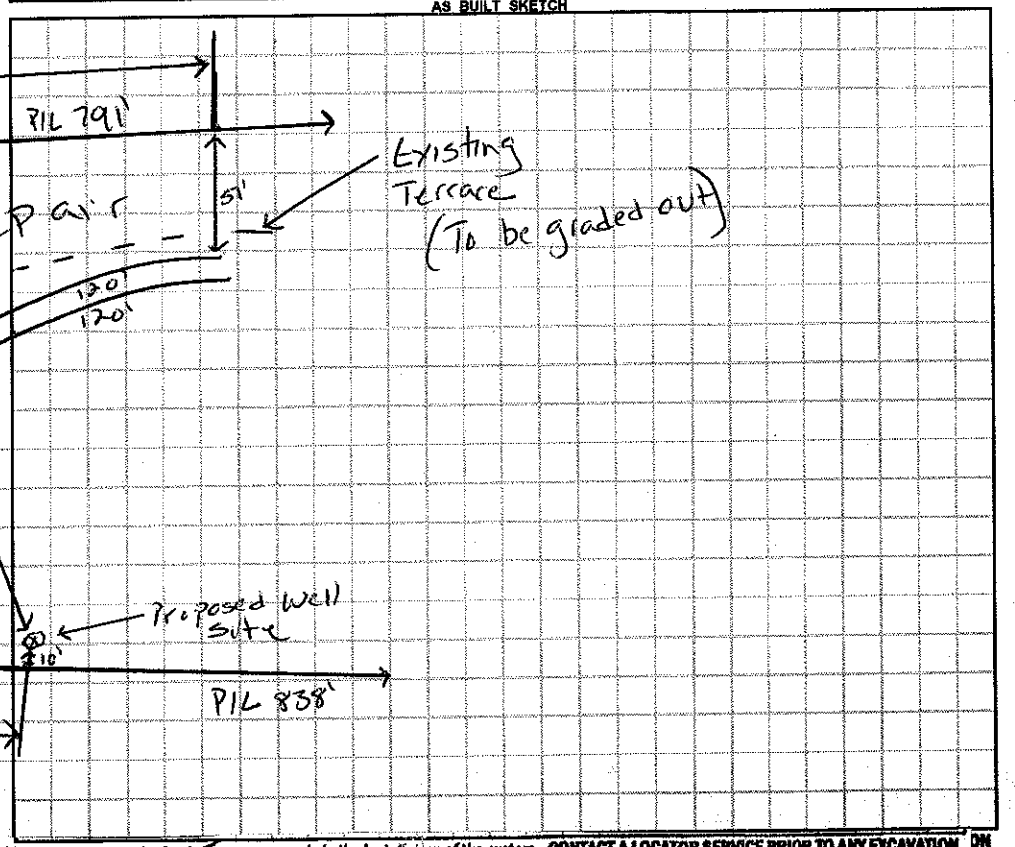

Permit can be suspended or revoked if any false information is supplied toward securing the permit / any unauthorized changes are made to the site / any unauthorized changes are made in the installation of the system. **CONTACT A LOCATOR SERVICE PRIOR TO ANY EXCAVATION** PIN no.

☐ **IMPROVEMENT PERMIT** *with plat valid without expiration.* ☑ **IMPROVEMENT PERMIT** *with site plan valid for 60 mos.* ☑ **AUTHORIZATION TO CONSTRUCT** *valid for period equal to IMPROVEMENT PERMIT--not to exceed 60 mo.*

Owner / Applicant Signature: Mark Hendricks Date:

IMPROVEMENT PERMIT by: Justin Henderson Date: 5-12-16

AUTHORIZATION TO CONSTRUCT by: Justin Henderson Date: 5-13-16

Installed by: Mark Hendricks Date: 10/4/16

OPERATION PERMIT by: W Sparks Date:

Existing System Inspected by: Date:

Health Dept. Copy - WHITE Applicant (Final Approval) - YELLOW Applicant (Conditional Approval) - PINK