IREDELL COUNTY HEALTH DEPARTMENT

STATESVILLE 704-878-5305 MOORESVILLE 704-664-5281

IMPROVEMENT PERMIT / AUTHORIZATION TO CONSTRUCT / OPERATION PERMIT / EXISTING SYSTEM INSPECTION

PERMIT# REPAIR PIN# 3783-53-3031 DATE 1-24-07

OWNER OR APPLICANT SARAH RUTH STAMPER PHONE: Business Home 704-873-6820

ADDRESS 130 BUCK LANE STATESVILLE NC 28625

LOCATION I-40 WEST, TR SHARON SCHOOL RD, TL WALNUT TREE RD, TL BUCK LANE 1ST HOUSE ON RIGHT

SUBDIVISION BLOCK / SECTION LOT LOT AREA 5.02 ACRES SITE CLASS. PS DESIGN FLOW 360 L.T.A.R. 0.30 GPD/FT²

Septic Tank: EXISTING Gallons: STB Date

Pump Tank: Gallons: PT Date

Pump Make: Model Serial No.

Nitrification Field: No Fields 1 Square Feet EQUIV 640 Linear Feet 140

No Lines TWO Trench Width 36" Max Trench Bottom Depth 36" + Gravel Depth N/A

☐ New System ☑ Repair ☐ Expansion System Type: I (II) III IV V VI

System Description:

Repair System Description: 25% REDUCTION, GRAVITY

Maintenance Agreement Required: ☐ Yes ☑ No

☑ House/Mod. Home No. Bedrooms 3

☐ Mobile Home No. Persons

☐ Business No. Employees

☐ Other


Water Supply: ☑ Individual ☐ Public ☐ Community WELL

☑ Gravity ☐ Pressure ☐ Slab ☐ Crawl Space ☑ Basement w/plumbing ☐ Basement wo/plumbing

Comments:/Conditions: INSTALL TWO NEW TRENCHES AT 36" PLUS (IN ORDER TO INSTALL BELOW FILL DIRT GRADE) AS FLAGGED ON SITE.

Comments:/Conditions:

INITIAL SITE SKETCH

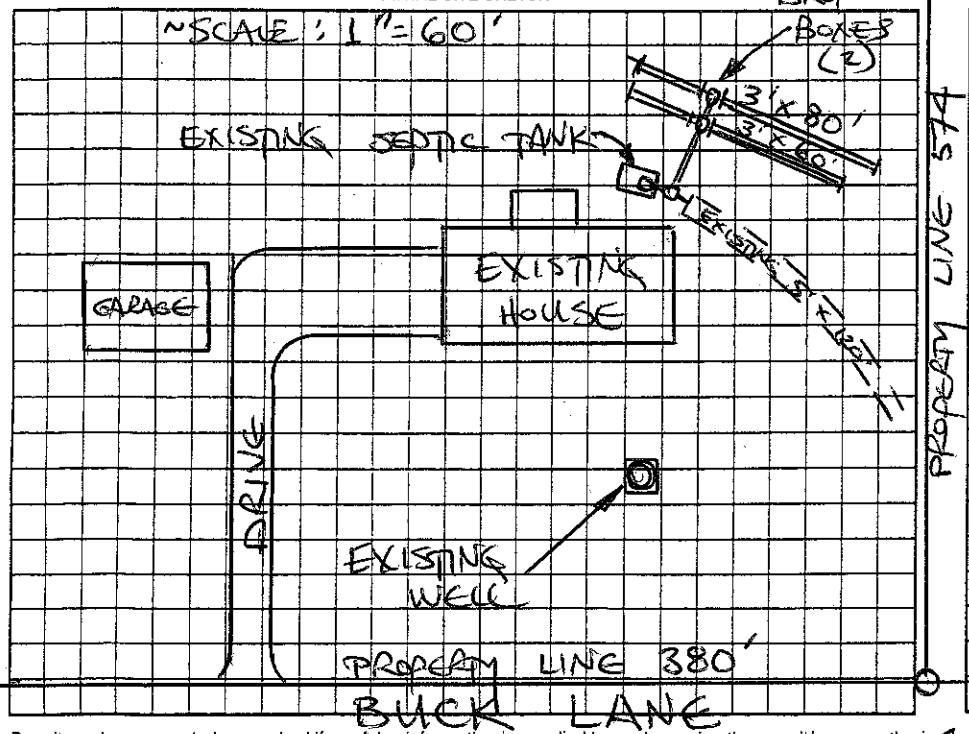

AS BUILT SKETCH

SYSTEM REPAIRED ACCORDING TO INITIAL SITE SKETCH

Permit can be suspended or revoked if any false information is supplied toward securing the permit/any unauthorized changes are made to the site/any unauthorized changes are made in the installation of the system. Improvement Permit with plat valid without expiration ☐ Improvement Permit with site plan valid for sixty months ☑ Authorization to Construct is valid for a period equal to that of Improvement Permit – not to exceed sixty months.

Signed: Sarah R Stamper date 1-24-07 Installed by: DAVID YOUNTS

Improvement Permit by: STEVE HEDRICK date 1-24-07 Operation Permit by: STEVE HEDRICK date 2-22-07

Authorization to Construct by: STEVE HEDRICK date 1-24-07 Existing System Inspection by: date

HEALTH DEPT. COPY: WHITE OWNER COPY (FINAL): YELLOW OWNER COPY (INITIAL): PINK