IREDELL COUNTY HEALTH DEPARTMENT

Statesville Phone TR 3-7271 Mooresville Phone NO 3-1271

PERMIT TO INSTALL SEPTIC TANK

Permit No. 9 Permit Date 7-25 1972

Owner Espy Gregory Address Statesville

Installed By Raymond Adams Address Hiddenite N.C.


Location of Property Out I-40 W to Sharon School Rd I.R. then L on #1501 - Cross Bridge then T.L. into Drive - House set back off Road

Tank		Capacity		Length of Lines		Fixtures	
Block	( )	1000	(✓)	225'	( )	No. of Baths	( )
Precast	(✓)	1250	( )	250'	( )	Dishwasher	( )
		1500	( )	Other 240		Garbage Grdr.	( )
		Other				Other	

NOTIFY HEALTH DEPARTMENT AT LEAST EIGHT HOURS BEFORE TANK IS TO BE INSPECTED.

Final Inspection 7-25 1972 Approved (✓) Disapproved ( ).

Remarks Well Not Down - House Not Complete

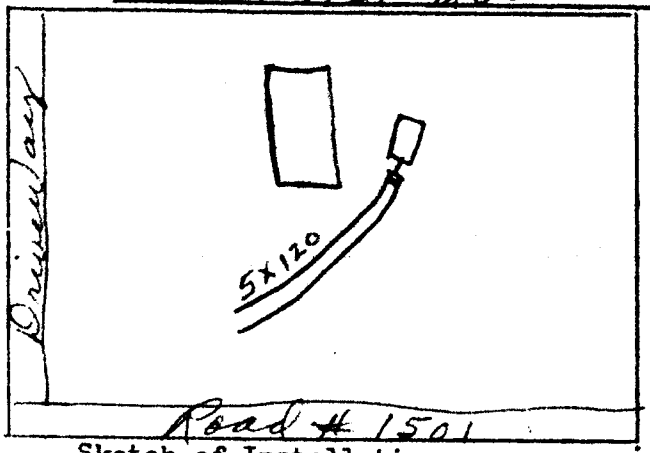

Sketch of Installation

E. G. Stevenson

Sanitarian