Repair

IREDELL COUNTY HEALTH DEPARTMENT

STATESVILLE 704-878-5305 — MOORESVILLE 704-664-5281

345

IMPROVEMENT PERMIT / CERTIFICATE OF COMPLETION / OPERATION PERMIT / EXISTING SYSTEM INSPECTION

PROPERTY DESCRIPTION NO. ~~Steve K. Duncan~~ DATE 6-26-97 TAX MAP NO. Repair Watershed: ☐ Yes ☐ No

OWNER OR CONTRACTOR Steve K. Duncan PHONE: Business _____ Home 872-2865

ADDRESS 332 Lookout Rd. Statesville NC

LOCATION I-40 TR Straven Sch TR Lookout Dr Rd Hawson (R)

SUBDIVISION _____ BLOCK / SECTION _____ LOT _____ LOT AREA _____ SITE CLASS. _____ DESIGN FLOW _____ L.T.A.R. _____

Septic Tank: 1000 Gallons; STB _____ Date _____

Pump Tank: Ex.sty Gallons; PT _____ Date _____

Pump Make: _____ Model _____ Serial No. _____

Nitrification Field: No Fields 2 Square Feet _____ Linear Feet 280

No Lines 2 Trench Width 36in Max Trench Bottom Depth 36in Gravel Depth 12in

☐ New System ☒ Repair System Type: I (II) III, IV, V, VI

System Description: _____

Repair System Description: _____

Maintenance Agreement Required: ☐ Yes ☒ No

☒ House/Mod. Home No. Bedrooms 3

☐ Mobile Home No. Bathrooms 1

☐ Business No. Employees ____

☐ Other _____


☐ Slab ☒ Crawl Space ☐ Basement w/plumbing ☐ Basement wo/plumbing

Water Supply: ☒ Individual ☐ Community ☐ Public


Comments: Keep Lines on Contour, 9ft on center
Check sanitary T Replace if Needed
Rep Boxes

Comments:

INITIAL SITE SKETCH

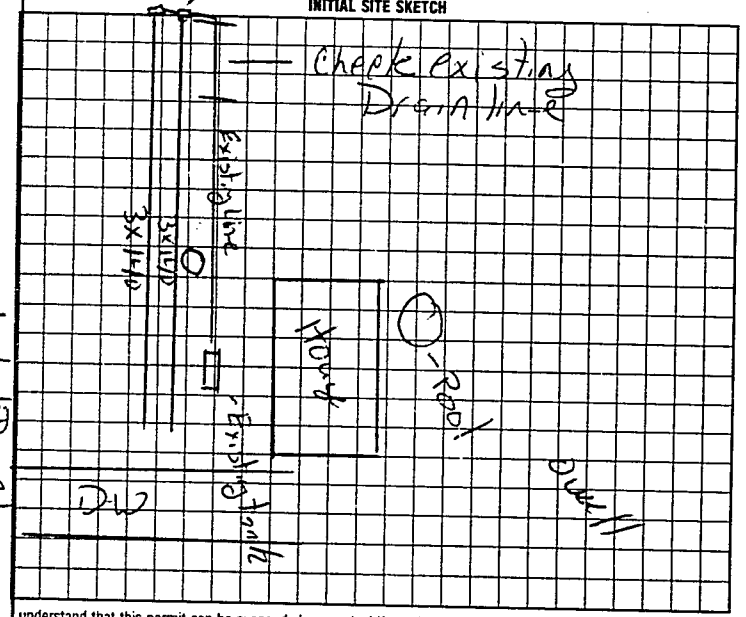

AS BUILT SKETCH

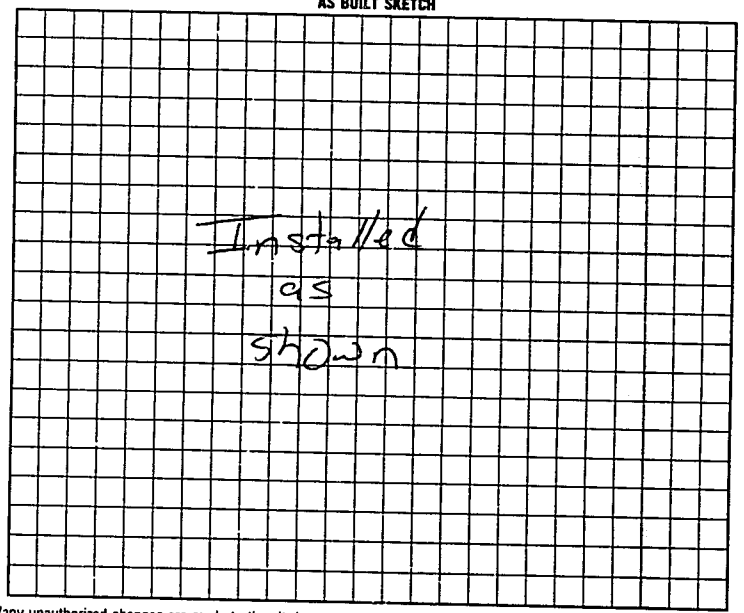

I understand that this permit can be suspended or revoked if any false information is supplied toward securing the permit/any unauthorized changes are made to the site/any unauthorized changes are made in the installation of the system. Improvement Permit is valid for 60 months from date of issuance.

Signed: Steve K Duncan

Improvement Permit by: Mary C Cox RS date 6-26-97

~~Existing System Inspection by:~~ Author, 24 Hour Tri Const.

Installed by: Berry Sigmon

Certificate of Completion by: _____ date _____

Operation Permit by: Mary C Cox RS date 7-25-97

HEALTH DEPT. COPY: WHITE — INSPECTION COPY (FINAL): GREEN — OWNER COPY (FINAL): YELLOW — INSPECTION COPY (INITIAL): PINK — OWNER COPY (INITIAL): GOLD