IREDELL COUNTY HEALTH DEPARTMENT

STATESVILLE 704-878-5305 MOORESVILLE 704-664-5281

IMPROVEMENT PERMIT / AUTHORIZATION TO CONSTRUCT / OPERATION PERMIT / EXISTING SYSTEM INSPECTION

PERMIT # 151490 PIN # 3783-63-7791 DATE 7 October 09

OWNER or APPLICANT Jackie B. Hudson PHONE: Business Home: (704) 880-0254

OWNER or APPLICANT ADDRESS 170 Hudson Lane Statesville, N.C.

LOCATION / DIRECTIONS Sharon School Rd. TL Walnut Tree - 1 mile on Right.

SUBDIVISION BLOCK / SECTION LOT # 1 LOT AREA 1.3Ac. DESIGN FLOW 360 gpd L.T.A.R. 0.3 gpd

Septic Tank 1000 Gallons: STB 1012 Date 9-24-09

Pump Tank Gallons: P T Date

Pump Make Model Serial #

Nitrification Field No Fields 1 No Lines 4 Linear Feet 300

Trench Width 36" Max. Trench Bottom Depth 36" Gravel Depth N/A

☑ New System ☐ Repair ☐ Expansion System Type I II III IV V VI

System Description: 25% Reduction System

Repair System Description: 25% Reduction system

Maintenance Agreement Required ☐ YES ☑ NO

☑ GRAVITY ☐ PRESSURE

☑ Residence No. Bedrooms 3

☐ Business No. Persons

☐ Other No. Employees

☐ Slab ☑ Crawl Space

☐ Basement w/plumbing ☐ Basement w/o plumbing

Water Supply: ☐ Private ☑ Public ☐ Community

Comments / Conditions

Keep ST. 20' from House to Allow for Sidewalk / Install as 4 lines 75' in length.


Keep waterline 10' from any portion of septic system.

Follow Contour / Fwd GAP distribution is Allowed.


Comments / Conditions

Fill Installed

INITIAL SITE SKETCH

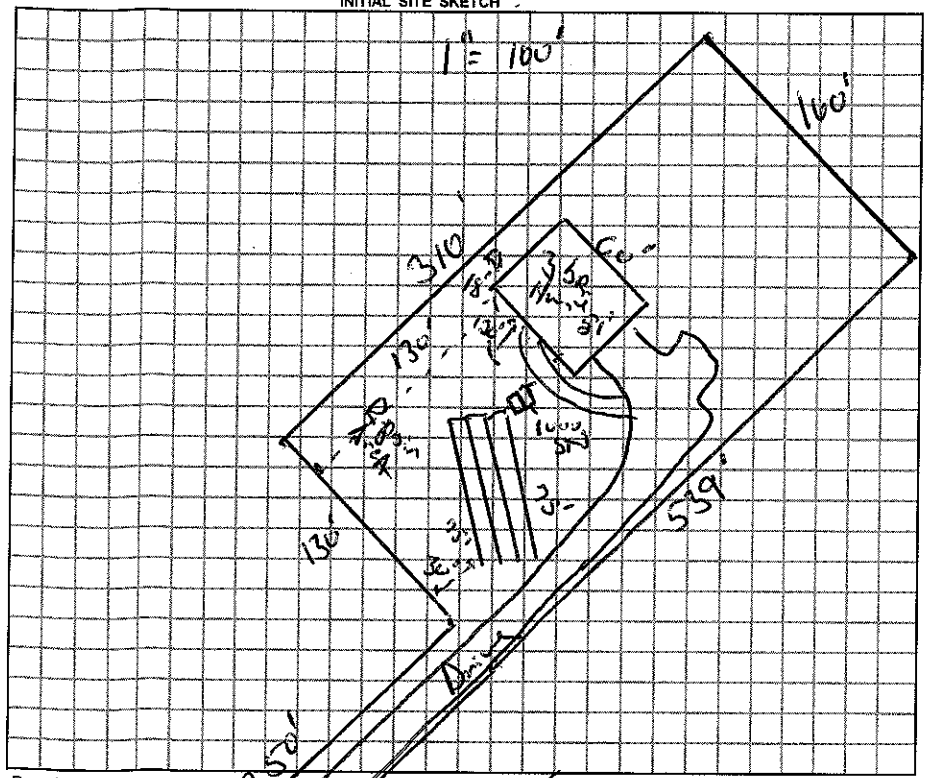

AS BUILT SKETCH

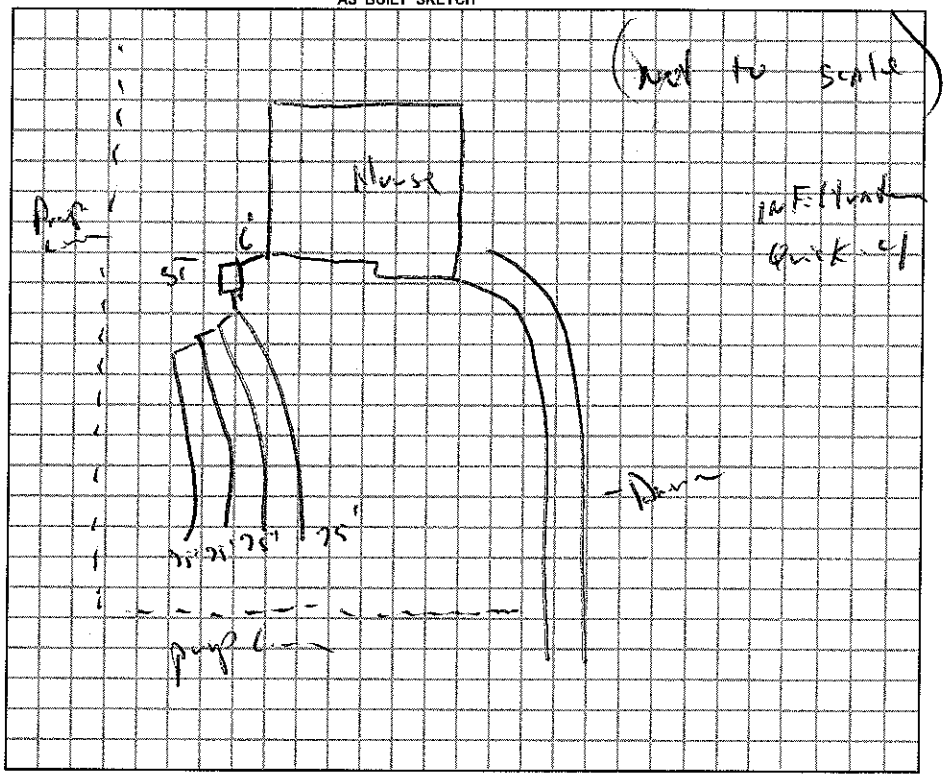

Permit can be suspended or revoked if any false information is supplied toward securing the permit / any unauthorized changes are made to the site / any unauthorized changes are made in the installation of the system.

☐ *IMPROVEMENT PERMIT w / plat valid without expiration.* ☑ *IMPROVEMENT PERMIT w / site plan valid for 60 mos.* ☑ *AUTHORIZATION TO CONSTRUCT valid for period equal to IMPROVEMENT PERMIT-not to exceed 60 mo.*

Applicant Signature: Date 10-8-09

ent Permit By: , R.S. Date 7 Oct. 09

to Construct by: , R.S. Date 7 Oct. 09

Installed by: Steve Jordan

Operation Permit by: , R.S. Date: 7 Jan. 2010

Existing System Inspected by: Date:

ULD CONTACT A LOCATOR SERVICE PRIOR TO ANY EXCAVATION.

WHITE COPY Environmental Health YELLOW COPY (Final) Owner / Applicant PINK COPY (Initial) Owner / Applicant