BLDR-2025-70639

ICHD - ENVIRONMENTAL HEALTH DIVISION

Statesville Office (704) 878-5305 x3456 | Mooresville Office (704) 660-3625

PERMIT : OSWP 2024-62519

SEPTIC: IMPROVEMENT PERMIT / AUTHORIZATION TO CONSTRUCT / OPERATION PERMIT / EXISTING SYSTEM

PIN # 3783 -- 67 -- 1573

APPLICANT/OWNER: Americas Home Place of Statesville | APPLICANT ADDRESS: 2144 Hilton Dr, Gainsville

SITE ADDRESS: 281 Lookout Dam Rd, Statesville 28625 | PHONE: 704-657-0840 | ALT. PHONE -

SITE DIRECTIONS: Sharon School - Lookout Dam | SAP CONTROLLED: ☐ YES ☒ NO

SUBDIVISION: - | SECTION: - | LOT # - | LOT AREA: 1.582 | DESIGN FLOW: 360 gpd | L.T.A.R.(Initial): 0.3 | L.T.A.R (Repair): 0.3


Septic Tank	1000 (gal)	STB	Date	☒ New System	☐ Repair	☐ Expansion	System Type: I (II) III IV V VI	☒ Residence	No. Bedrooms 3
Pump Tank	(gal)	PT	Date	System Description:	25% reduction			☐ Business	No. Persons 6
Pump Make	Model		Serial #	Repair System Description:	25% reduction			☐ Other	No. Employees
# Nitrification Fields	1 # Lines 3		Linear Ft 300'	Maintenance Agreement Required:	☐ YES	☒ NO		☐ Slab	☒ Crawl Space
Trench Width 36in	*Max. Trench Depth(Initial) 31in		*Max. Trench Depth(Repair) 31in	Gravel Depth -	☒ GRAVITY	☐ PRESSURE		☐ Basement w/plumbing	☐ Basement w/o plumbing

Water Supply: ☒ Private ☐ Public ☐ Community

* Measured on the downhill side of the trench | Effluent Standard: ☒ DSE ☐ HSE ☐ TS-I ☐ TS-II ☐ RCW ☐ NSF/ANSI 40 | Usable Depth to LC (Initial): 48in | Usable Depth to LC (Repair): 48in | *Limiting Condition*


Comments / Conditions: Install on contour with the land. Do not drive, park, or grade septic area.

INITIAL SITE SKETCH

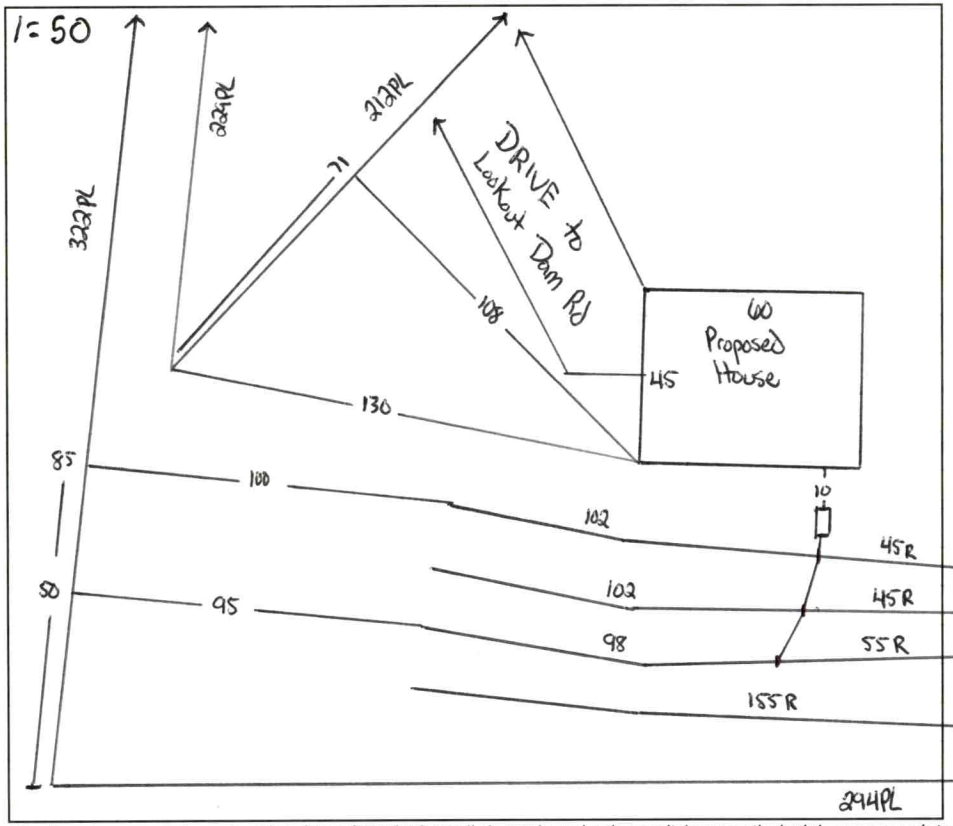

AS BUILT SKETCH

FOR SEPTIC FINAL INSPECTION CALL: 704-664-3703 between 8am-9am the day the inspection is needed. Be sure to speak with an inspector to confirm your time.

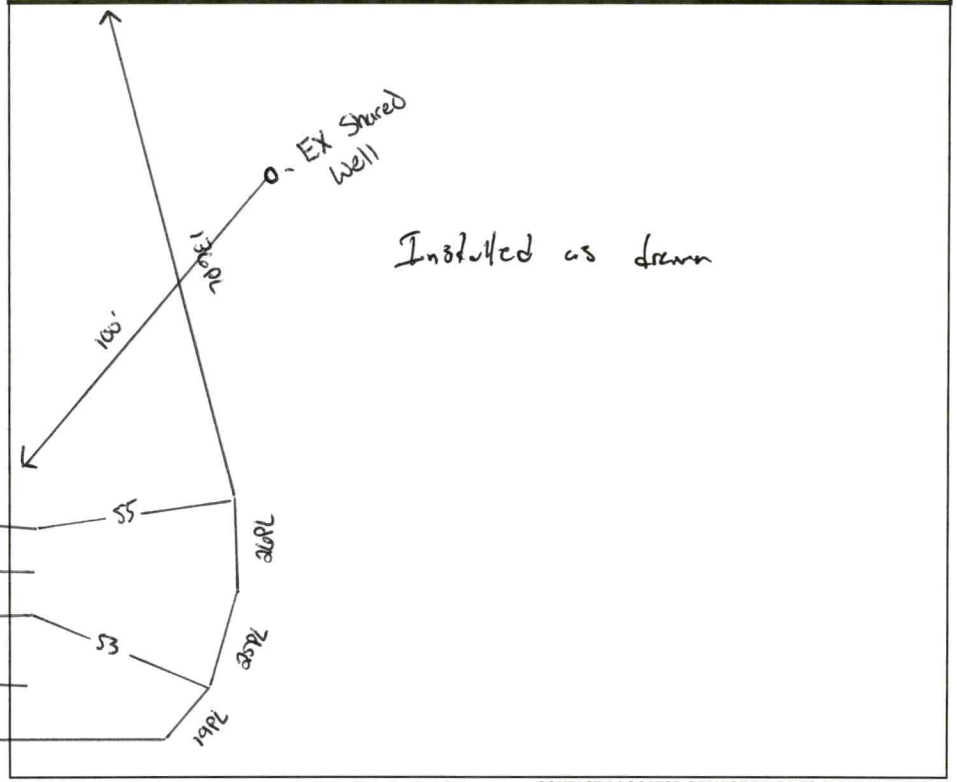

Permit can be suspended or revoked if any false information is supplied toward securing the permit / any unauthorized changes are made to the site / any unauthorized changes are made in the installation of the system. **CONTACT A LOCATOR SERVICE PRIOR TO ANY EXCAVATION**

☐ **IMPROVEMENT PERMIT** ***with plat*** *valid without expiration.* ☒ **IMPROVEMENT PERMIT** ***with site plan*** *valid for 60 mos.* ☒ **AUTHORIZATION TO CONSTRUCT** *valid for period equal to IMPROVEMENT PERMIT--not to exceed 60 mo.*


Owner / Applicant Signature: Online Signature | Date: | Installed by: Eli Pope

IMPROVEMENT PERMIT by: Cory Hill | Date: 10/4/24 | OPERATION PERMIT by: Matt Wilke | Date: 5/9/25

AUTHORIZATION TO CONSTRUCT by: Cory Hill | Date: 10/9/24 | Existing System Inspected by: | Date:

Item	Date	Initials
Drain Lines Checked		
Tanks Checked		
Pressure Manifold or Valve Box Checked		
Pressure Head Set		
Electrical Checked		
Floats Set		
Alarm Checked		
Maintenance Contract Needed? Y / N		
Comments:		

Repairs Only	
	State Code
Failing System Code	
Type of Distribution	G or P
Type of Failure/Malfunction	
Primary Cause of Failure/Malfunction	
Age of System? _____	
Initial or Repair? _____	

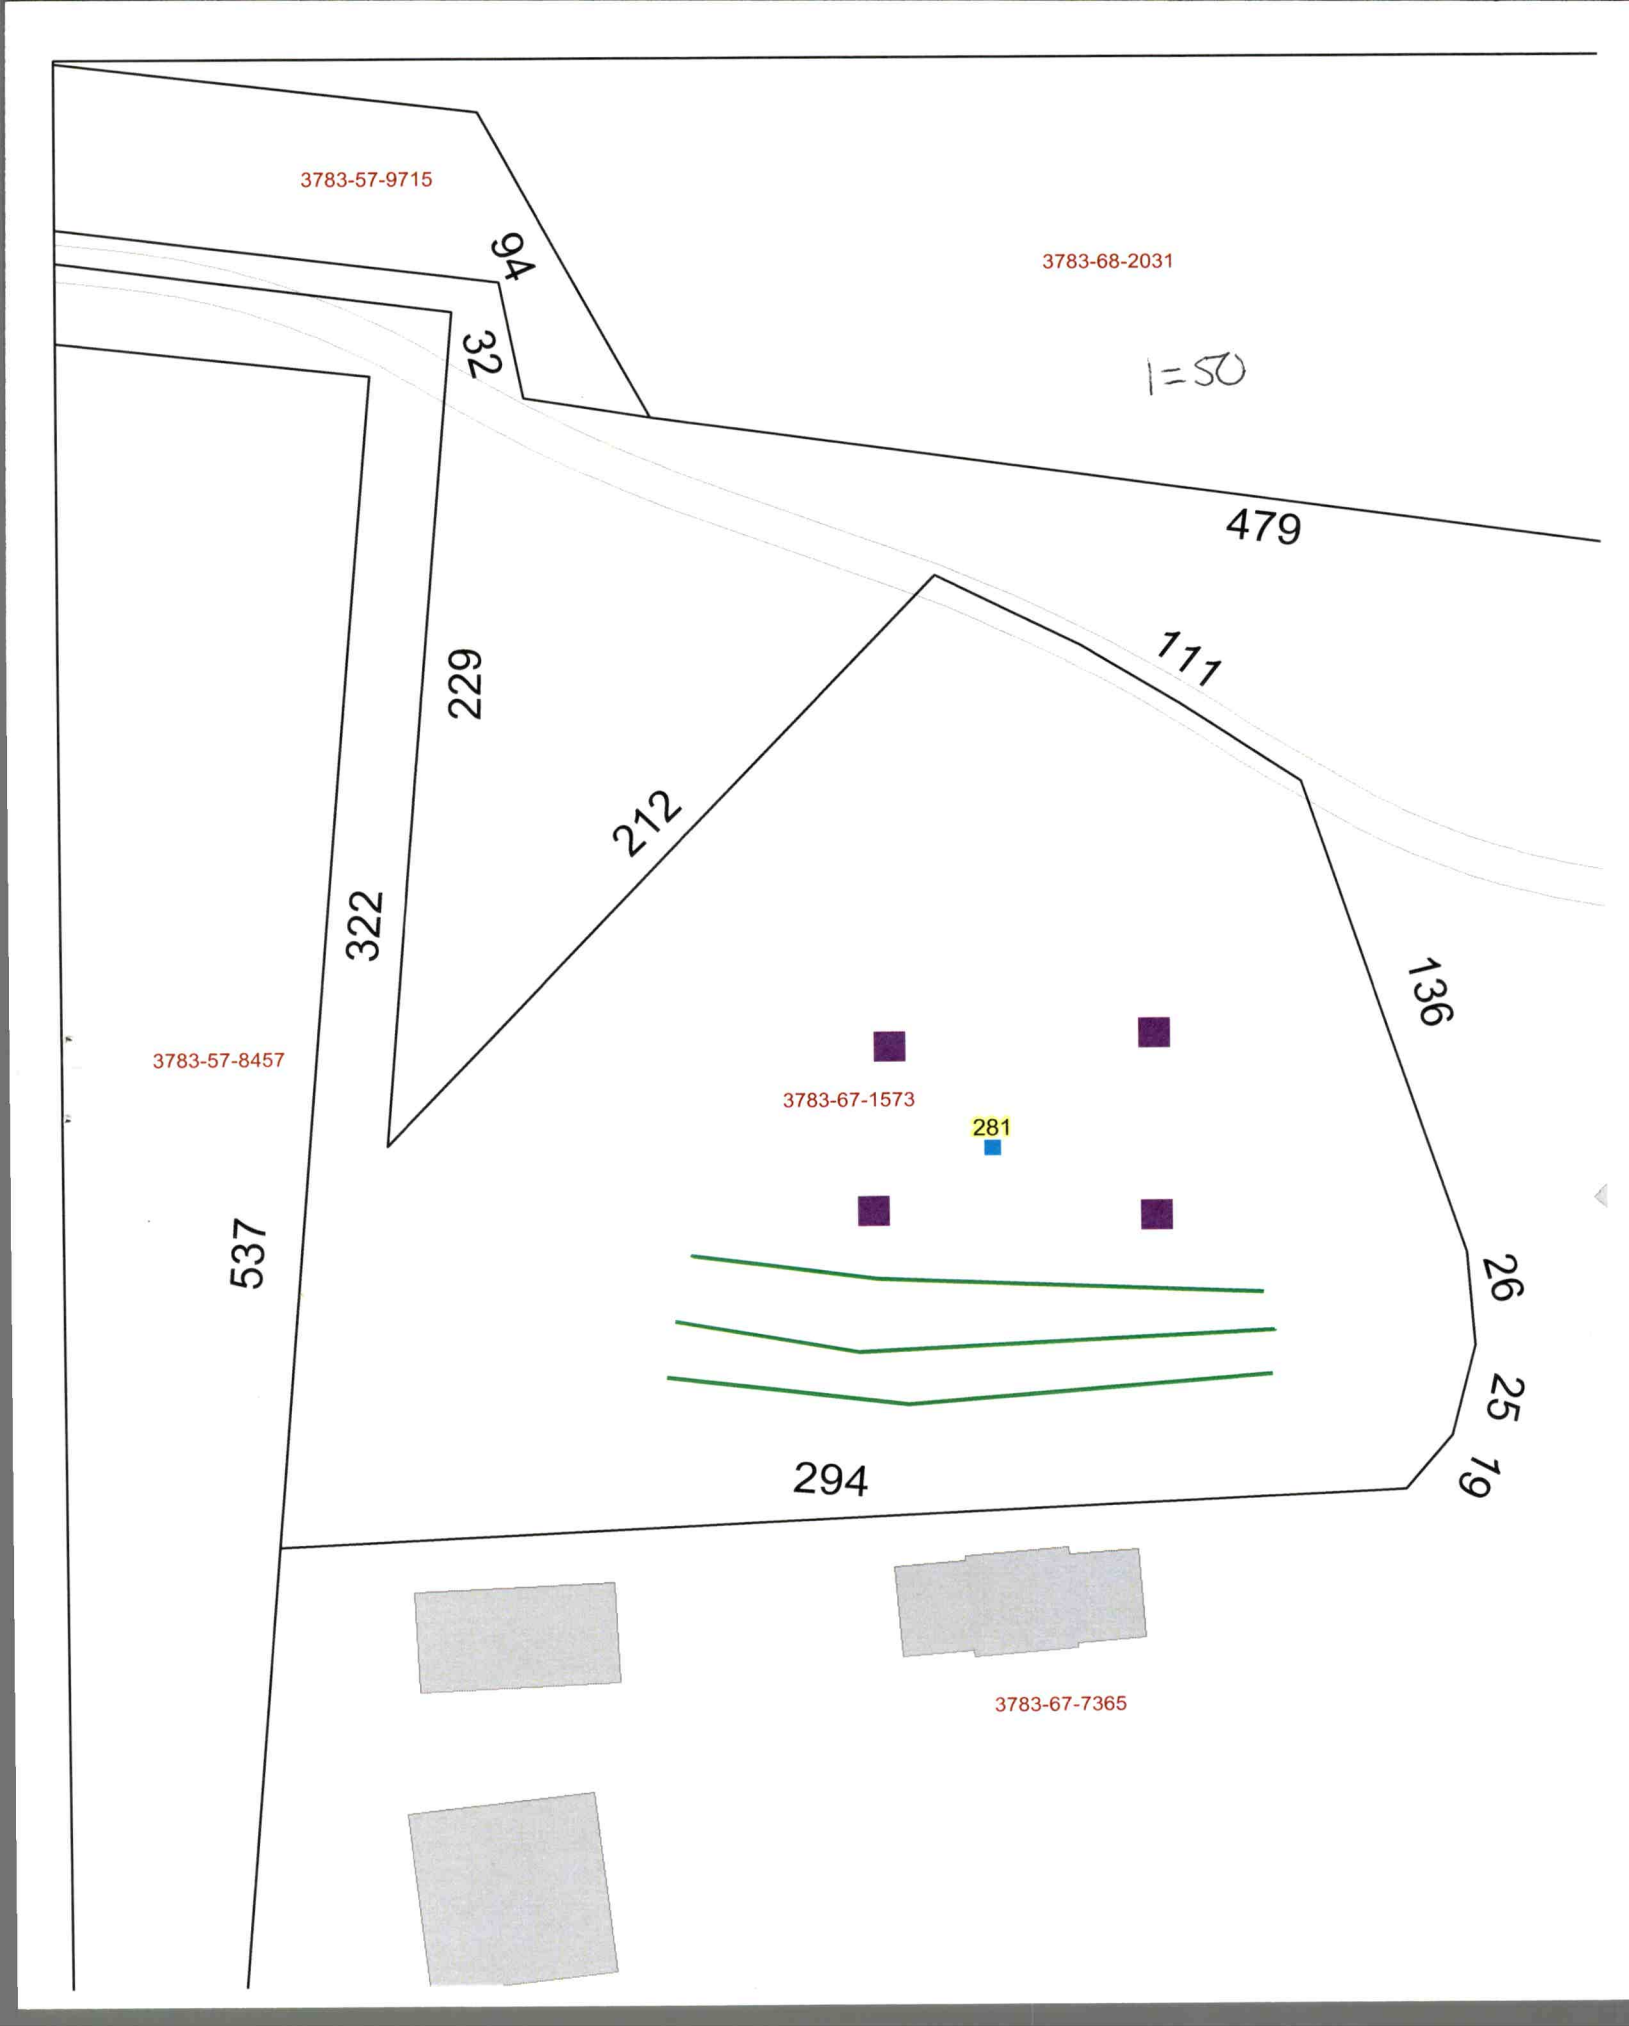
3783-57-9715
94
3783-68-2031
32
1=50
479
111
229
212
322
136
3783-57-8457
3783-67-1573
281
537
26
25
19
294
3783-67-7365