IREDELL COUNTY HEALTH DEPARTMENT

STATESVILLE 704-878-5305 ✓ MOORESVILLE 704-664-5281

IMPROVEMENT PERMIT / AUTHORIZATION TO CONSTRUCT / OPERATION PERMIT / EXISTING SYSTEM INSPECTION

PERMIT# 102690 PIN# 3783-68-4556 Susan Wood DATE 10/11/01

OWNER OR CONTRACTOR Ronald Miller PHONE: Business (704) 873-2548 ✓ Home

ADDRESS 232 Lookout Dam Rd Statesville NC 28625

LOCATION I-40 W, ① on Sherrill School Rd, ② on Lookout Dam Rd, on Right about 3/10 mile

SUBDIVISION – BLOCK / SECTION – LOT – LOT AREA 1.0 Acre SITE CLASS PS DESIGN FLOW 360 L.T.A.R. .30

Septic Tank: 4000 Gallons: STB 1012 Date 7/24/01
Pump Tank: Gallons: PT Date
Pump Make: Model equivalent to Serial No.
Nitrification Field: No. Fields 1 Square Feet 4200 Linear Feet 300
No. Lines 6 Trench Width 36" Max Trench Bottom Depth 36" Gravel Depth –

☒ New System ☐ Repair System Type: I, II, III, IV, V
System Description: Gravity 25% Reduction
Repair System Description: Gravity 50% Reduction
Maintenance Agreement Required: ☐ Yes ☒ No
☐ Slab ☒ Crawl Space ☐ Basement w/plumbing ☐ Basement wo/plumbing

☐ House/Mod. Home No. Bedrooms 3
☒ Mobile Home No. Bathrooms 2
☐ Business No. Employees
☐ Other


Water Supply: ☒ Individual ☐ Public ☐ Community

Comments/Conditions: ① Maintain Proper Setbacks ② Install System on Contour using 25% Reduction System ③ Keep well 100' from Septic System


Comments/Conditions: – Installed 30ft of HDES Sections – Poly Lok Filter Installed – Septic Tank Manhole Installed

Not to Scale

INITIAL SITE SKETCH

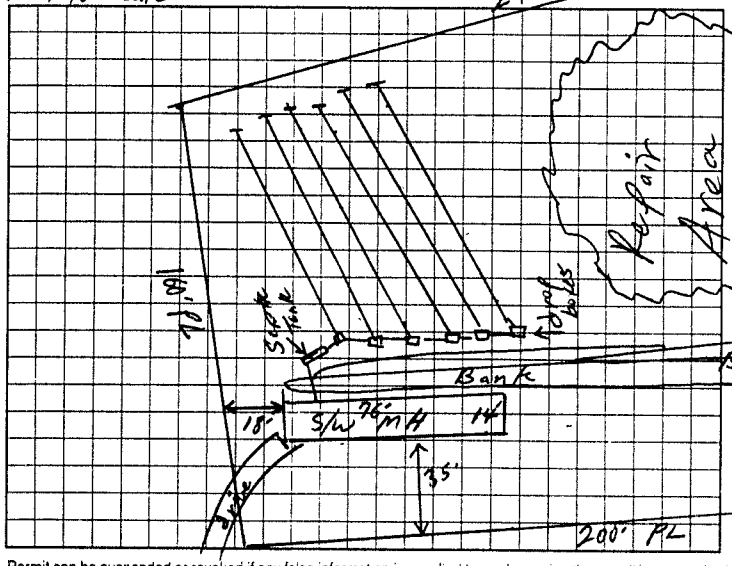

AS BUILT SKETCH

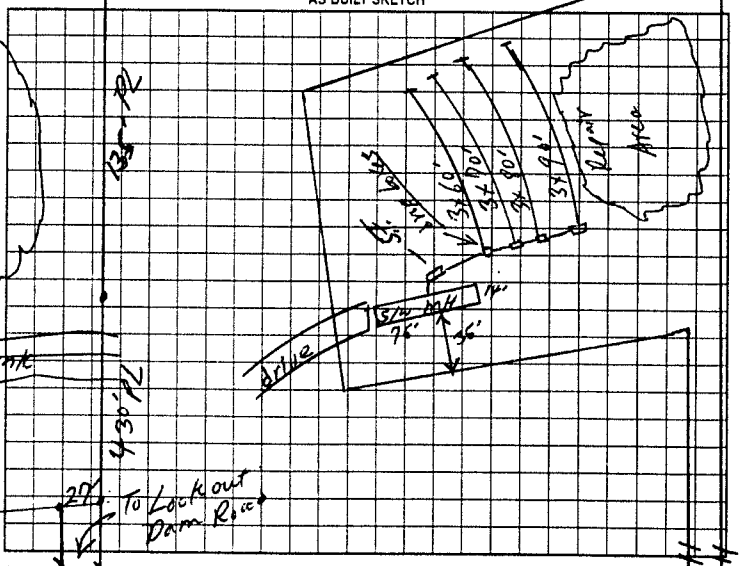

Permit can be suspended or revoked if any false information is supplied toward securing the permit/any unauthorized changes are made to the site/any unauthorized changes are made in the installation of the system. Improvement Permit with plat valid without expiration. Improvement Permit with site plan valid for sixty months. Authorization to Construct is valid for a period equal to that of Improvement Permit – not to exceed sixty months.

Signed: Susan Wood date 10/11/01
Improvement Permit by: William O. Johnson date 10/11/01
Authorization to Construct by: William O. Johnson date 10/11/01

Installed by: A-1 Grading
Operation Permit by: William O. Johnson date 1/14/01
Existing System Inspection by: date

HEALTH DEPT. COPY WHITE OWNER COPY (FINAL) YELLOW OWNER COPY (INITIAL) PINK