IREDELL COUNTY HEALTH DEPARTMENT

STATESVILLE 704-878-5305 (C7) ✓ MOORESVILLE 704-664-5281

IMPROVEMENT PERMIT / AUTHORIZATION TO CONSTRUCT / OPERATION PERMIT / EXISTING SYSTEM INSPECTION

PERMIT# 104000 PIN# 3783-74-4398 DATE 2/19/02

OWNER OR CONTRACTOR Gena Bowery PHONE Business — Home (704) 585-2864

ADDRESS P.O. Box 520 Stoby Point N.C. 28678

LOCATION I-40 West, @ Shann School Road, @ Walnut Tree Rd, go abt 3/4 mile @ on sharp curve turn Right, lot on left.


SUBDIVISION — BLOCK / SECTION — LOT — LOT AREA 2.74 AC SITE CLASS 1 DESIGN FLOW 450 L T A R .30

Septic Tank: Ex 1,000 Gallons STB — Date —	X New System Repair System Type (1) Trench	House/Mod Home No Bedrooms 4	Water Supply:
Pump Tank: — Gallons PT — Date —	System Description Gravity, Conventional	X Mobile Home No Bathrooms 2	X Individual
Pump Make: — Model — Serial No —	Repair System Description Gravity / 25% Reduction	Business No Employees —	☐ Public
Nitrification Field: No Fields 1 Square Feet 900 Linear Feet 300'	Maintenance Agreement Required: Yes X No	Other —	☐ Community
No Lines 4 @ 75' Trench Width 36" Max Trench Bottom Depth 36" Gravel Depth 12"	Slab X Crawl Space Basement w/plumbing Basement wo/plumbing		

Comments /Conditions: (1) Add 30 ft of Line on contour with one (1) Flow divider + drop box (2) (2) Replace distribution box if necessary (3) maintain proper setbacks (Not To Scale)

Comments Conditions

INITIAL SITE SKETCH

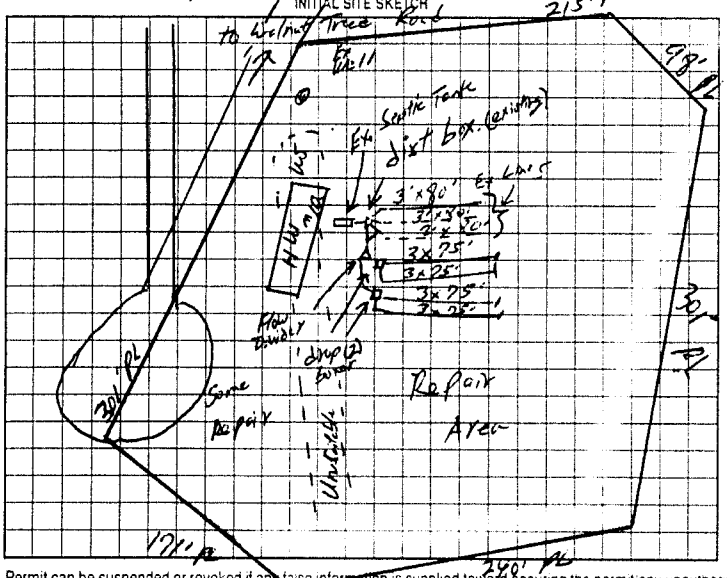

AS BUILT SKETCH

Installed as shown per Initial Site Sketch

Permit can be suspended or revoked if any false information is supplied toward securing the permit any unauthorized changes are made to the site any unauthorized changes are made in the installation of the system. Improvement Permit with plat valid without expiration. Improvement Permit with site plan valid for sixty months. Authorization to Construct is valid for a period equal to that of Improvement Permit - not to exceed sixty months

Signed: Gena Bowery date 2/19/02 Installed by Bill Greene

Improvement Permit by William A Johnson date 2/19/02 Operation Permit by William A Johnson date 6/5/02

Authorization to Construct by: William A. Johnson date 2/19/02 Existing System Inspection by: — date —

HEALTH DEPT COPY WHITE OWNER COPY (FINAL) YELLOW OWNER COPY (INITIAL) PINK