IREDELL COUNTY HEALTH DEPARTMENT

STATESVILLE 704-878-5305 MOORESVILLE 704-664-5281

CI

IMPROVEMENT PERMIT / AUTHORIZATION TO CONSTRUCT / OPERATION PERMIT / EXISTING SYSTEM INSPECTION

PERMIT# 122996 PIN# 3783-74-4617 DATE 8/11/04

OWNER OR CONTRACTOR Roger Berge PHONE: Business — Home (704) 872-7886

ADDRESS 644 Hartness Rd. Statesville N.C. 28677

LOCATION I-40 west, @ on Sharon Chal Rd, @ on Walnut Tree @ Oxford Scenic Ct, Lot on left in cul-de-sac

SUBDIVISION Walnut Tree BLOCK / SECTION — LOT 3 LOT AREA 2.443 Ac. SITE CLASS. P5 DESIGN FLOW 480 L.T.A.R. —

Septic Tank: 1,000 Gallons; STB 760 Date ~~7-20-04~~ 5-20-04

Pump Tank: — Gallons; PT — Date —

Pump Make: — Model — Serial No. —

Nitrification Field: No Fields 1 Square Feet 1372 Linear Feet 460

No Lines 4@115 Trench Width 36" Max Trench Bottom Depth 28" Gravel Depth 12"

☒ New System ☐ Repair System Type: ☒ I, ☐ II, III, IV, V, VI

System Description: Gravity, Conventional

Repair System Description: Gravity, 25% Reduction

Maintenance Agreement Required: ☐ Yes ☒ No

☐ House/Mod. Home ☒ Mobile Home ☐ Business ☐ Other

No. Bedrooms 4 No. Bathrooms 3 No. Employees —

☐ Slab ☒ Crawl Space ☐ Basement w/plumbing ☐ Basement wo/plumbing

Water Supply: ☒ Individual ☐ Public ☐ Community

Comments/Conditions: ① Install lines maximum of 28" deep on contour ② Keep well 100 ft from septic system ③ Maintain proper setbacks ④ Install French Drain as shown ⑤ Do not install when wet


Comments/Conditions: POLYLOK FILTER & MARKER

V'D LINES & TANK NEED FRENCH DRAIN

V'D. INSTALLED AS DRAWN & FLAGGED ON THE LOT. SYSTEM INSTALLED 28" DEEP IN NATURAL SOIL. HAD SOME FILL ON IT FROM GRADING OUT HOUSE SITE.

INITIAL SITE SKETCH

Scale 1" = 100'

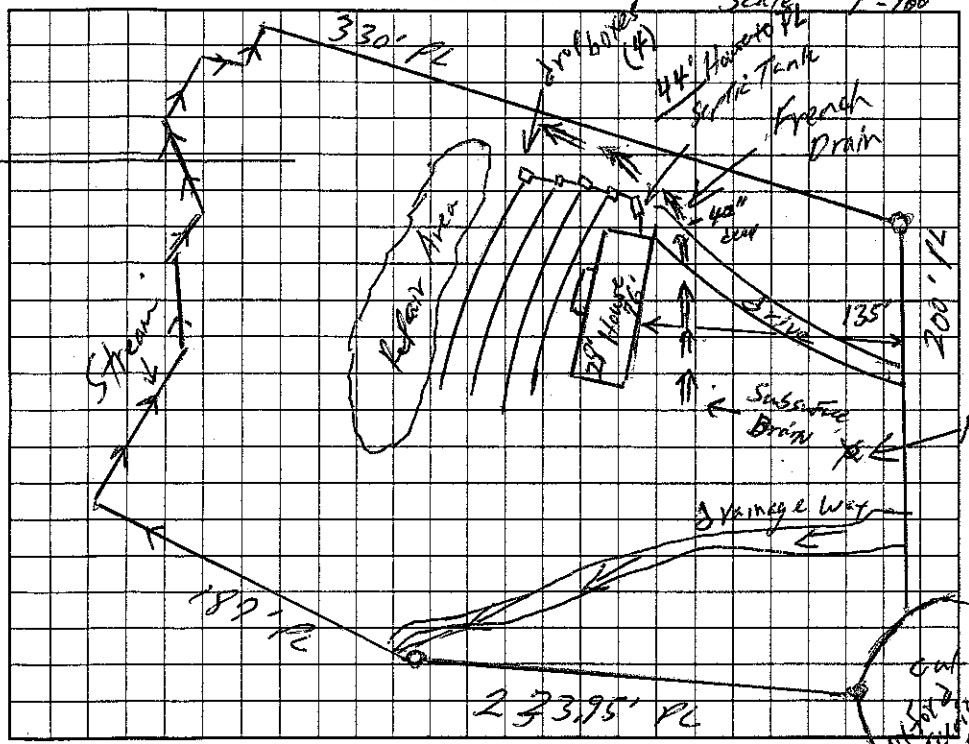

AS BUILT SKETCH

- NEEDS FRENCH DRAIN V'D
- V'D FRENCH DRAIN ON 10-19-04 INSTALLED AS DRAWN. INSTALLER STATED THE P/L & I.D. IS NOT ACROSS P/L, LOANE

Permit can be suspended or revoked if any false information is supplied toward securing the permit/any unauthorized changes are made to the site/any unauthorized changes are made in the installation of the system. Improvement Permit with plat valid without expiration. Improvement Permit with site plan valid for sixty months. Authorization to Construct is valid for a period equal to that of Improvement Permit – not to exceed sixty months.

Signed: Martha Berge date 8/11/04 Installed by: ABBEE GRADING

Improvement Permit by: William O. Johnson date 8/11/04 Operation Permit by: [signature] RS date 10-19-04

Authorization to Construct by: William O. Johnson date 8/11/04 Existing System Inspection by: — date —

HEALTH DEPT. COPY: WHITE OWNER COPY (FINAL): YELLOW OWNER COPY (INITIAL): PINK