IREDELL COUNTY HEALTH DEPARTMENT

STATESVILLE 704-878-5305 CI MOORESVILLE 704-664-5281

IMPROVEMENT PERMIT / AUTHORIZATION TO CONSTRUCT / OPERATION PERMIT / EXISTING SYSTEM INSPECTION

PERMIT# 1/00033 20 PIN# 3783-74-8818 DATE 12/12/02

OWNER OR CONTRACTOR Tiffany Karriker PHONE: Business — Home (704) 892-1802

ADDRESS 212 Mecklynn Road Mooresville, N.C. 28115

LOCATION I-40 W (R) Sharon School Rd (L) Walnut Tree Rd (R) Oxford Serre Ct, at end

SUBDIVISION WALNUT TREE BLOCK / SECTION — LOT 5 LOT AREA 2.426Ac SITE CLASS. PS DESIGN FLOW 480 L.T.A.R. .25 gpd/ft²

Septic Tank: 1,000 Gallons; STB 794 Date 2-30-03
Pump Tank: 1,000 Gallons; PT Date 2-20-03
Pump Make: ~~Zoeller~~ Crowe Model WEOSIIH Serial No. C0337157
Nitrification Field: No Fields 1 Square Feet 1920 Linear Feet 480
No Lines 6@80' Trench Width 36" Max Trench Bottom Depth 36" Gravel Depth NA

☒ New System ☐ Repair System Type: I, II, III, IV, V, VI
System Description: Pump, 25% Reduction
Repair System Description: Pump, 50% Reduction
Maintenance Agreement Required: ☐ Yes ☐ No


☐ House/Mod. Home ☒ Mobile Home ☐ Business ☐ Other
No. Bedrooms 4 No. Bathrooms 3 No. Employees

☐ Slab ☒ Crawl Space ☐ Basement w/plumbing ☐ Basement wo/plumbing

Water Supply: ☒ Individual ☐ Public ☐ Community


Comments:/Conditions: (1) Call Health Dept to flag out lines before Septic System Installation (2) Contact HD. for proper pump sizing (3) Install lines on contour (4) Install French Drain 48" deep to daylight (5) Key well 100ft from system

INITIAL SITE SKETCH (Not to Scale)

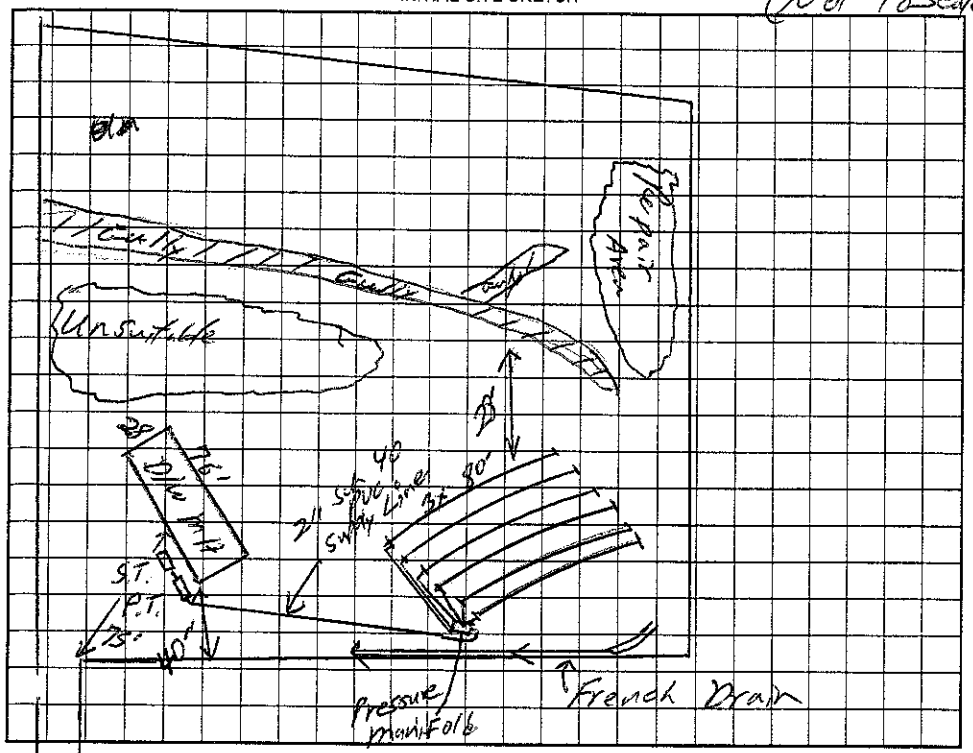

Comments:/Conditions: 1st Line okay - 4/29; 2 3 4th Liner okay - 4/30; 5th + 6th Line okay 5" tanks + Float okay 5"; Zabel filter + ST meter Installed; French Drain inspected - ok - 5/8/03 mk Electrical + Alarm okay - 5/16/03 mk

AS BUILT SKETCH (Not to Scale)

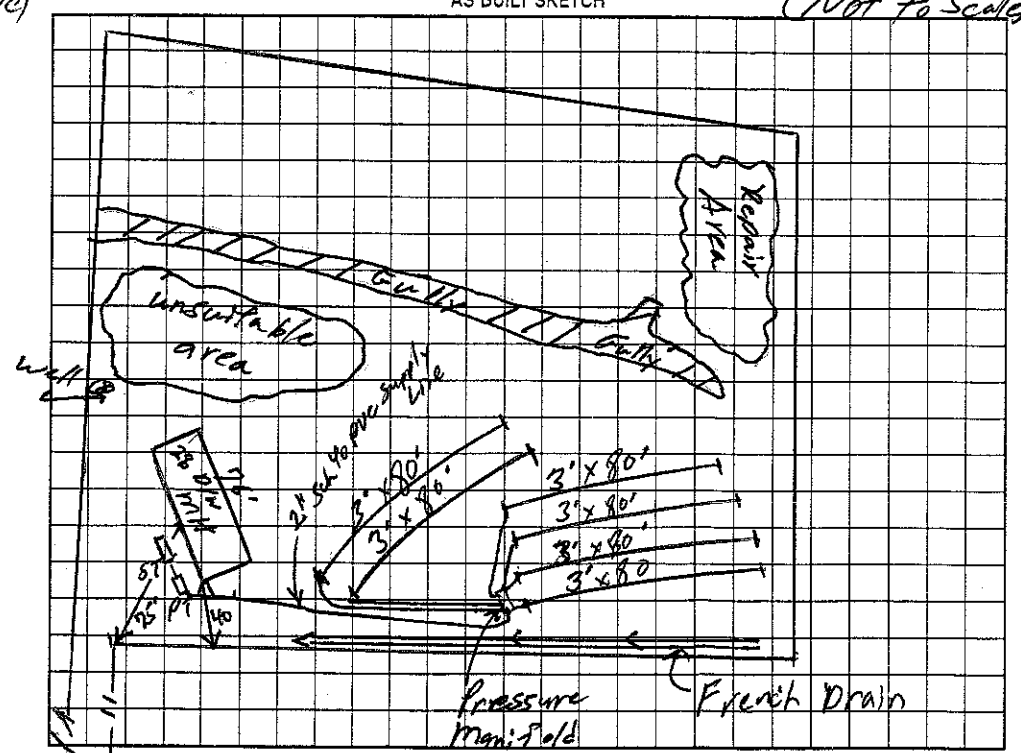

Permit can be suspended or revoked if any false information is supplied toward securing the permit/any unauthorized changes are made to the site/any unauthorized changes are made in the installation of the system. Improvement Permit with plat valid without expiration. Improvement Permit with site plan valid for sixty months. Authorization to Construct is valid for a period equal to that of Improvement Permit – not to exceed sixty months.

Signed: Tiffany Karriker date 12/27/02 Installed by: Bobs Backhoe

Improvement Permit by: William O. Johnson date 12/12/02 Operation Permit by: William O. Johnson date 5/16/03

Authorization to Construct by: William O. Johnson date 12/12/02 Existing System Inspection by: _____ date _____

HEALTH DEPT. COPY: WHITE OWNER COPY (FINAL): YELLOW OWNER COPY (INITIAL): PINK