IREDELL COUNTY HEALTH DEPARTMENT

STATESVILLE 704-878-5305 MOORESVILLE 704-664-5281

IMPROVEMENT PERMIT / CERTIFICATE OF COMPLETION / OPERATION PERMIT / EXISTING SYSTEM INSPECTION

PROPERTY DESCRIPTION NO. 26121 DATE 3-11-97 TAX MAP NO. 37837 81682 Watershed: ☒ Yes ☐ No

OWNER OR CONTRACTOR Robert Beam Jr PHONE: Business _____ Home 8719849 WSIDPA

ADDRESS 199 Loshout Dam Rd Statesville NC

LOCATION I-40 TR Shannon Sch TR Loshout Dam Rd House on left Past Church

SUBDIVISION _____ BLOCK / SECTION _____ LOT _____ LOT AREA _____ SITE CLASS. 01 5 DESIGN FLOW 120T Req'd L.T.A.R. _____

Septic Tank: 1000 Existing Gallons; STB _____ Date _____

Pump Tank: _____ Gallons; PT _____ Date _____

Pump Make _____ Model _____ Serial No. _____

Nitrification Field: No Fields 2 Square Feet _____ Linear Feet 200

No Lines 2 Trench Width 36in Max Trench Bottom Depth 24-36in Gravel Depth 12

☒ New System ☐ Repair System Type: I, II, III, IV, V, VI

System Description: Gravity Conventional

Repair System Description: _____

Maintenance Agreement Required: ☐ Yes ☐ No

☐ House/Mod. Home No. Bedrooms 4

☒ Mobile Home No. Bathrooms 2

☐ Business No. Employees _____

☐ Other _____


☐ Slab ☐ Crawl Space ☐ Basement w/plumbing ☐ Basement wo/plumbing

Water Supply:
☒ Individual
☐ Community
☐ Public


Comments: Keeplines on contour 9ft on center

Comments:

INITIAL SITE SKETCH

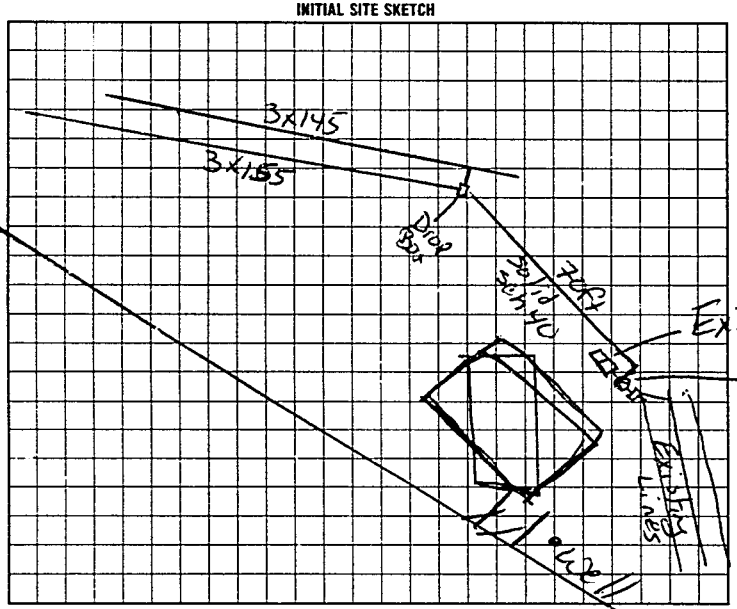

AS BUILT SKETCH

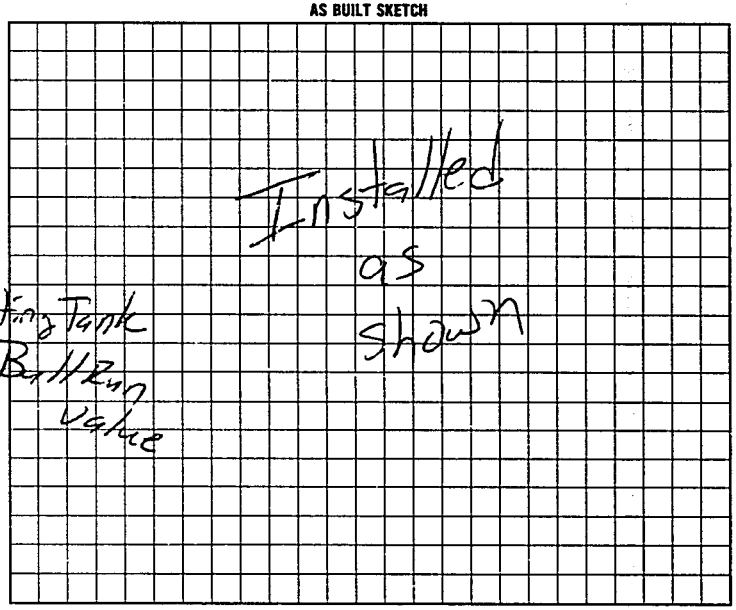

I understand that this permit can be suspended or revoked if any false information is supplied toward securing the permit/any unauthorized changes are made to the site/any unauthorized changes are made in the installation of the system. Improvement Permit is valid for 60 months from date of issuance. Authorization to const. expires 5 yrs from issued date

Signed: Sonya Beam Installed by: Esker Elder

Improvement Permit by: Mark C Ott RS date 3-11-97 Certificate of Completion by: _____ date _____

Existing System Inspection by: Authorization to const. Mark C Ott RS date 3-11-97 Operation Permit by: Mark C Ott RS date 3-18-97

HEALTH DEPT COPY WHITE INSPECTION COPY (FINAL) GREEN OWNER COPY (FINAL) YELLOW INSPECTION COPY (INITIAL) PINK OWNER COPY (INITIAL) GOLD

8 7 1 2 0 0