IREDELL COUNTY HEALTH DEPARTMENT

STATESVILLE 704-878-5305 MOORESVILLE 704-664-5281

IMPROVEMENT PERMIT / AUTHORIZATION TO CONSTRUCT / OPERATION PERMIT / EXISTING SYSTEM INSPECTION

PERMIT# Repair PIN# 3783-85-2017 DATE 12/5/03

OWNER OR CONTRACTOR Charles Crabtree PHONE: Business — Home (704) 873-8338

ADDRESS 146 Walnut Tree Rd. Statesville NC 28625

LOCATION I-40 E (R) Shiloh School Rd (L) Walnut Tree Rd e 146 Walnut Tree Rd on Left

SUBDIVISION — BLOCK / SECTION — LOT — LOT AREA 49.76 Ac SITE CLASS. PS DESIGN FLOW 360 L.T.A.R. Ex

Septic Tank: Existing Gallons: STB — Date —
Pump Tank: — Gallons: PT — Date —
Pump Make: — Model — Serial No. —
Nitrification Field: No Fields 1 Square Feet 900 Linear Feet 360'
No Lines 3@100 Trench Width 36" Max Trench Bottom Depth 30" Gravel Depth 12"

☐ New System ☒ Repair System Type: I (II) III, IV, V, VI
System Description: —
Repair System Description: Gravity Conventional
Maintenance Agreement Required: ☐ Yes ☐ No

☒ House/Mod. Home No. Bedrooms 3
☐ Mobile Home No. Bathrooms 2
☐ Business No. Employees —
☐ Other —


☐ Slab ☒ Crawl Space ☐ Basement w/plumbing ☐ Basement wo/plumbing

Water Supply: ☒ Individual ☒ Public ☐ Community

Comments:/Conditions: (1) Pump out Septic Tank (2) Replace Septic Tank tee if needed (3) discover old supply line (3) Add ~149' of supply line + 300 ft Nitrification Lines as shown on Contour

Comments:/Conditions:
- Replaced Septic Tee
- Installed 310ft of Nitrification line

INITIAL SITE SKETCH

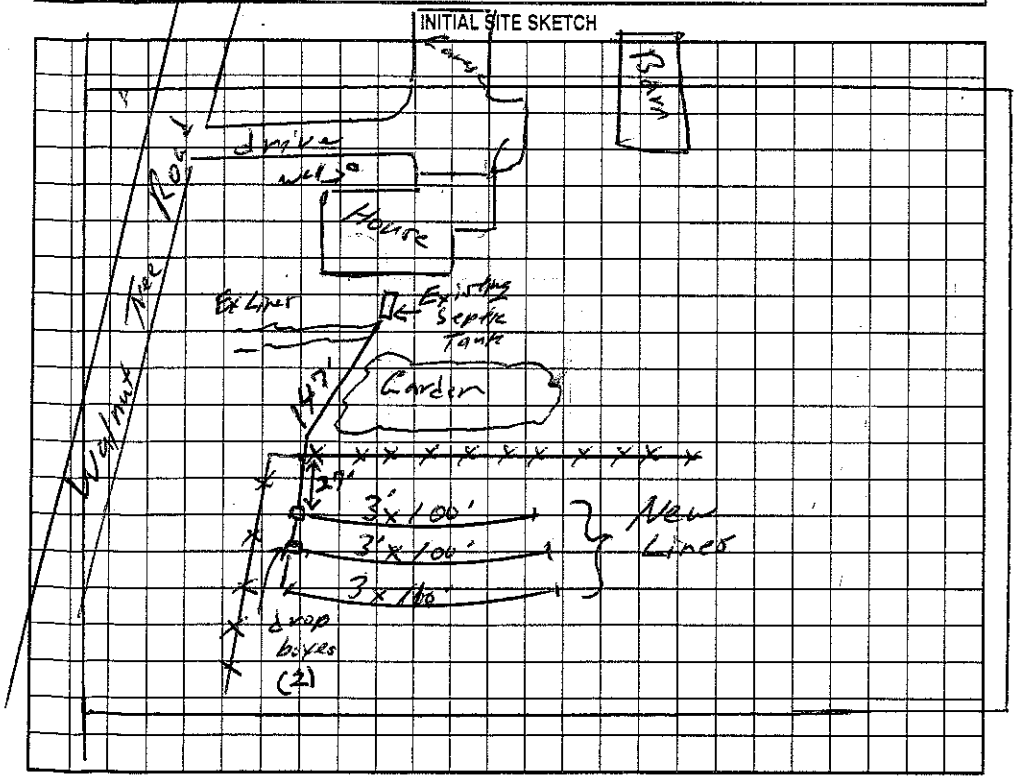

AS BUILT SKETCH

Installed As Shown per Initial Site Sketch

Permit can be suspended or revoked if any false information is supplied toward securing the permit/any unauthorized changes are made to the site/any unauthorized changes are made in the installation of the system. Improvement Permit with plat valid without expiration. Improvement Permit with site plan valid for sixty months. Authorization to Construct is valid for a period equal to that of Improvement Permit – not to exceed sixty months.

Signed: [signature] date 12-5-03 Installed by: James Hudler

Improvement Permit by: William O. Johnson date 12/5/03 Operation Permit by: William O. Johnson date 12/29/03

Authorization to Construct by: William O. Johnson date 12/5/03 Existing System Inspection by: — date —

HEALTH DEPT. COPY: WHITE OWNER COPY (FINAL): YELLOW OWNER COPY (INITIAL): PINK