IREDELL COUNTY HEALTH DEPARTMENT

STATESVILLE 704-878-5305 MOORESVILLE 704-664-5281

IMPROVEMENT PERMIT / AUTHORIZATION TO CONSTRUCT / OPERATION PERMIT / EXISTING SYSTEM INSPECTION

PERMIT# 103324 PIN# 3783-85-7646 DATE 12/4/01

OWNER OR CONTRACTOR James Setzer (Joe Setzer) PHONE: Business (704) 873-4978 Home (704) 878-9243

ADDRESS 3223 Turnay Avenue, Statesville N.C. 28677

LOCATION I 40 W, R Sharon School Rd, go past 2nd Brick house between rocks on ... at Pond.

SUBDIVISION – BLOCK / SECTION – LOT – LOT AREA 21.42 Acres SITE CLASS PS DESIGN FLOW 360 L.T.A.R. .3

Septic Tank: 1,000 Gallons; STB 312 Date 3-25-02

Pump Tank: 1,000 Gallons; PT 283 Date 3-25-02

Pump Make: Model Serial No.

Nitrification Field: No Fields 1 Square Feet 1200 Linear Feet 400

No Lines 5@ 80' Trench Width 36" Max Trench Bottom Depth 36" Gravel Depth 12"

☒ New System ☐ Repair System Type: I, II, (III), IV, V, VI

System Description: Pump, Conventional

Repair System Description: Pump, Conventional

Maintenance Agreement Required: ☐ Yes ☐ No

☒ House/Mod. Home ☐ Mobile Home ☐ Business ☐ Other

No. Bedrooms 3 No. Bathrooms 2 No. Employees


Water Supply: ☒ Individual ☐ Public ☐ Community

☐ Slab ☒ Crawl Space ☐ Basement w/plumbing ☐ Basement wo/plumbing

Comments/Conditions: (1) do not install when wet (2) maintain proper setbacks - Keep Tanks + System 50 ft from pond

Comments/Conditions: - PT + ST - Inspected - okay 4/3/02 (WOJ)
- Zabel Filter, Septic Tank marker installed - 4/3/02 (WOJ)
- lines checked okay - 5/9/02 WOJ
- Set pressure checked Floats okay 6/5/02
- Electrical + Alarm okay 6/6/02 BS

INITIAL SITE SKETCH

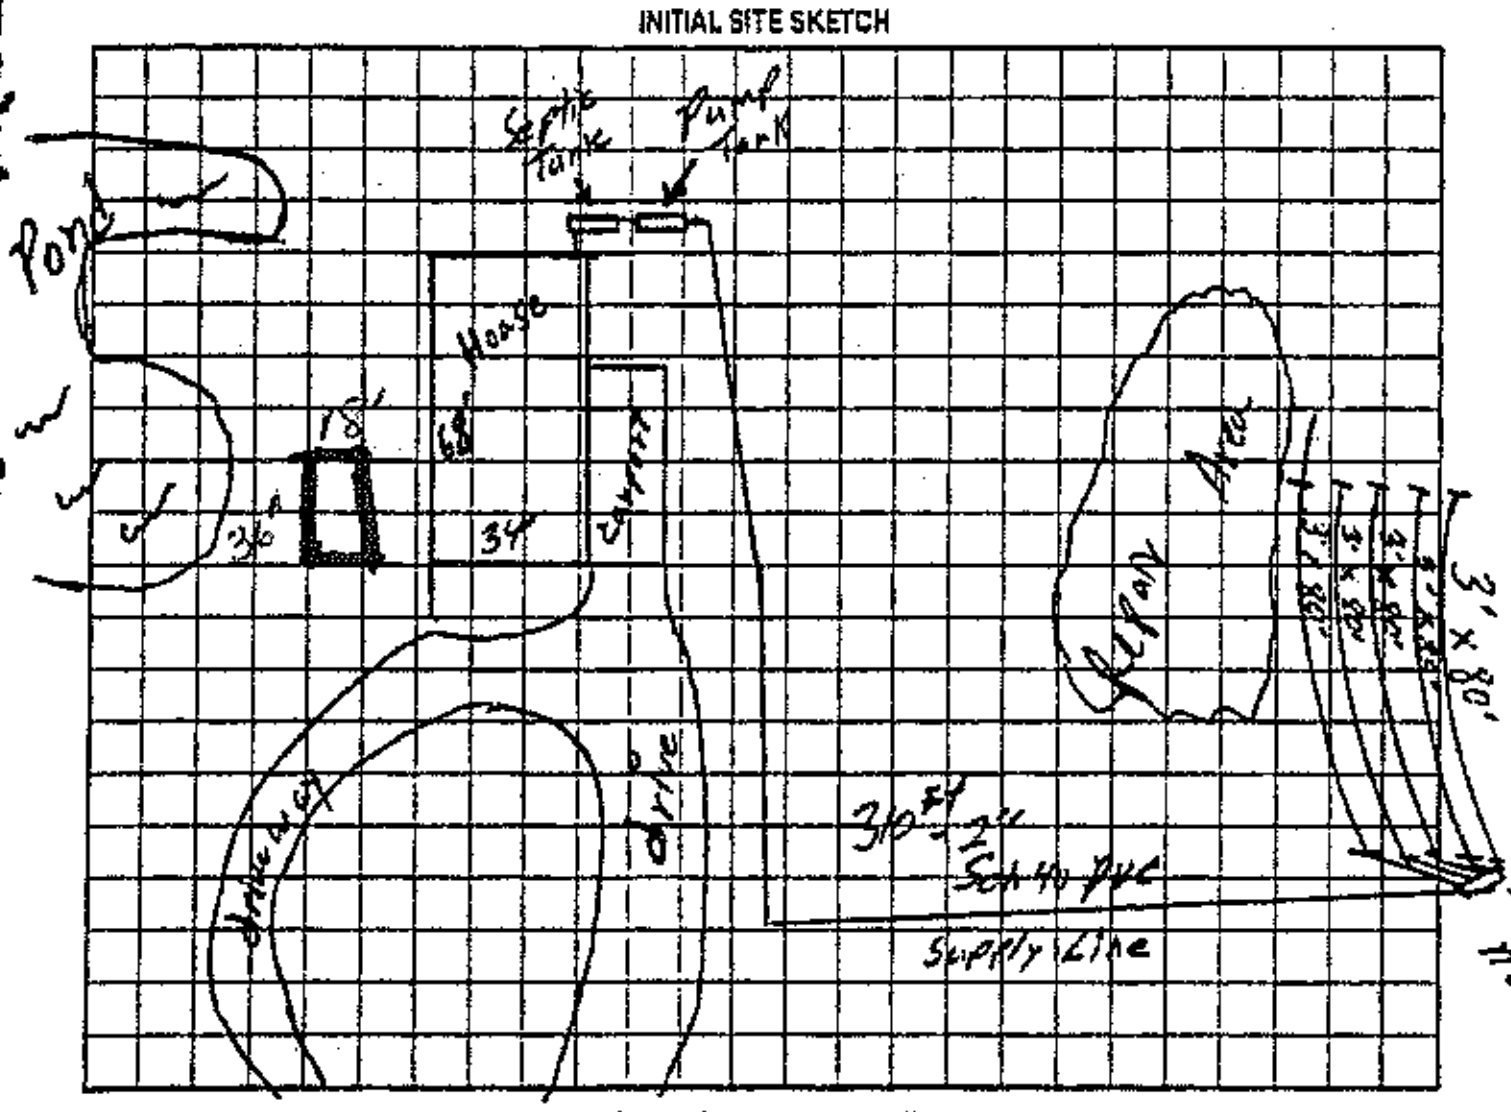

AS BUILT SKETCH

Installed as shown per Initial Site Sketch

Permit can be suspended or revoked if any false information is supplied toward securing the permit/any unauthorized changes are made to the site/any unauthorized changes are made in the installation of the system. Improvement Permit with plat valid without expiration. Improvement Permit with site plan valid for sixty months. Authorization to Construct is valid for a period equal to that of Improvement Permit – not to exceed sixty months.

Signed: Marie Setzer date

Installed by: Charles Baity

Improvement Permit by: William O. Johnson date 12/12/01

Operation Permit by: William O. Johnson date 6/6/02

Authorization to Construct by: William O. Johnson date 12/12/01

Existing System Inspection by: date

HEALTH DEPT COPY: WHITE OWNER COPY (FINAL): YELLOW OWNER COPY (INITIAL): PINK

The location of the proposed 18X36 Pool addition does not appear to impact the existing septic system. **NOTE: [signature] REHS

Date: 4-4-11

ICHD-Environmental Health Division