This permit replaces/voids permit dated 5-11-99

IREDELL COUNTY HEALTH DEPARTMENT

STATESVILLE 704-878-5305 MOORESVILLE 704-664-5281

IMPROVEMENT PERMIT / AUTHORIZATION TO CONSTRUCT / OPERATION PERMIT / EXISTING SYSTEM INSPECTION

PERMIT# Repair PIN# DATE 5-26-99

OWNER OR CONTRACTOR Kenneth Sipes PHONE: Business Home

ADDRESS 793 Sharon Sch Rd Statesville

LOCATION 40 W TR Sharon Sch House On (L) at Box 793

SUBDIVISION BLOCK / SECTION LOT LOT AREA SITE CLASS DESIGN FLOW 240 L.T.A.R.

Septic Tank: Existing Gallons; STB 1012 Date 4-11-99
Pump Tank: Gallons; PT Date
Pump Make: Model Serial No.
Nitrification Field: No Fields 1 Square Feet Linear Feet
No Lines 2 Trench Width 6ft Max Trench Bottom Depth 36in + Gravel Depth 20in

☐ New System ☒ Repair System Type: I. (II.) III. IV. V. VI
System Description:
Repair System Description: Gravity Bed Conv.
Maintenance Agreement Required: ☐ Yes ☐ No


☒ House/Mod. Home No. Bedrooms 2
☐ Mobile Home No. Bathrooms 1
☐ Business No. Employees
☐ Other
☐ Slab ☒ Crawl Space ☐ Basement w/plumbing ☐ Basement wo/plumbing

Water Supply: ☒ Individual ☐ Public ☐ Community

Comments/Conditions: Replace first 20-30ft of old Bed add new Bed section 20in stone Check sanitary T, replace if needed Pump tank Run 2 lines in new Bed

Comments/Conditions: ☒ New Tank installed, New 6x 65ft section NOT installed

INITIAL SITE SKETCH

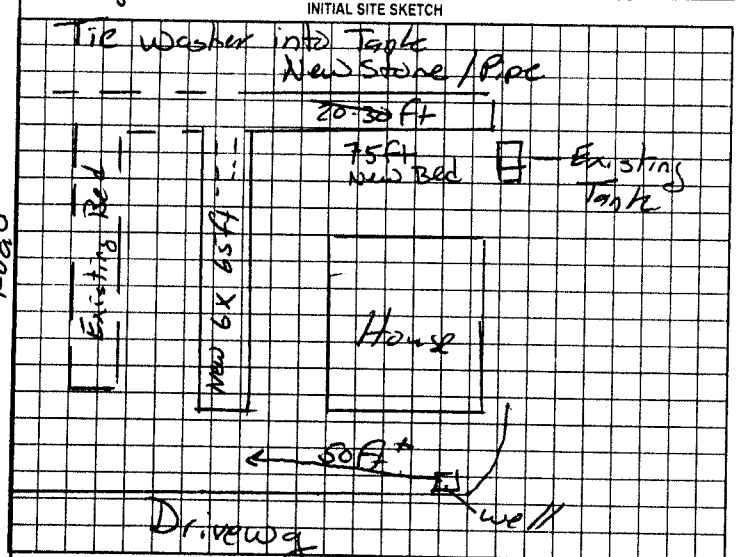

AS BUILT SKETCH

6x 75ft off old bed replace w/ 20in Stone Hooked into 4" (dry) section of old system.

Permit can be suspended or revoked if any false information is supplied toward securing the permit/any unauthorized changes are made to the site/any unauthorized changes are made in the installation of the system. Improvement Permit with plat valid without expiration. Improvement Permit with site plan valid for sixty months. Authorization to Construct is valid for a period equal to that of Improvement Permit – not to exceed sixty months.

Signed: Wilma Y. Sipes date 5-26-99 Installed by: Esker Elder

Improvement Permit by: Mary C Cox RS date 5-26-99 Operation Permit by: Mary C Cox RS date 5-28-99

Authorization to Construct by: Mary C Cox RS date 5-26-99 Existing System Inspection by: date

(HEALTH DEPT COPY WHITE) OWNER COPY (FINAL) YELLOW OWNER COPY (INITIAL) PINK