# IREDELL COUNTY HEALTH DEPARTMENT

STATESVILLE 704-878-5305 MOORESVILLE 704-664-5281

## IMPROVEMENT PERMIT / AUTHORIZATION TO CONSTRUCT / OPERATION PERMIT / EXISTING SYSTEM INSPECTION

PERMIT# 134595 PIN# 3783-89-8973 DATE 7-5-06

OWNER OR CONTRACTOR JOHNNY WILHELM PHONE: Business 704-929-9095 Home 704-278-1291

ADDRESS 120 POWLAS ROAD CLEVELAND, NC 27013

LOCATION I-40 WEST TR SHARON SCHOOL ROAD, ON RIGHT AT BOX # 788

SUBDIVISION SHARON TRACT BLOCK / SECTION I LOT 6 LOT AREA 0.51 ACRE SITE CLASS. PS DESIGN FLOW 360 L.T.A.R. 0.30 GPD/FT²

Septic Tank: 1000 Gallons; STB 1012 Date 3-12-06
Pump Tank: _____ Gallons; PT _____ Date _____
Pump Make: _____ Model _____ Serial No. _____
Nitrification Field: No Fields 1 Square Feet EQP/200 Linear Feet 300
No Lines THREE Trench Width 36" Max Trench Bottom Depth 36" Gravel Depth NA

☑ New System ☐ Repair System Type: I (II), III, IV, V, VI
System Description: 25% REDUCTION, GRAVITY
Repair System Description: 50% REDUCTION, LOW PRESSURE
Maintenance Agreement Required: ☐ Yes ☑ No ☐ Other


☑ House/Mod. Home ☐ Mobile Home ☐ Business
No. Bedrooms 3 No. Bathrooms ____ No. Employees ____
☐ Slab ☑ Crawl Space ☐ Basement w/plumbing ☐ Basement wo/plumbing

Water Supply: ☑ Individual ☑ Public ☐ Community

Comments/Conditions: ① INSTALL 25% REDUCTION SYSTEM ON CONTOUR AS SHOWN, MINIMUM 10' FROM PROPERTY LINE ② SEE ATTACHED GW-30 FOR WELL ABANDONMENT

Comments/Conditions: SEPTIC TANK W/ MARKER INSTALLED USING "TUFFTE" FILTER

INITIAL SITE SKETCH

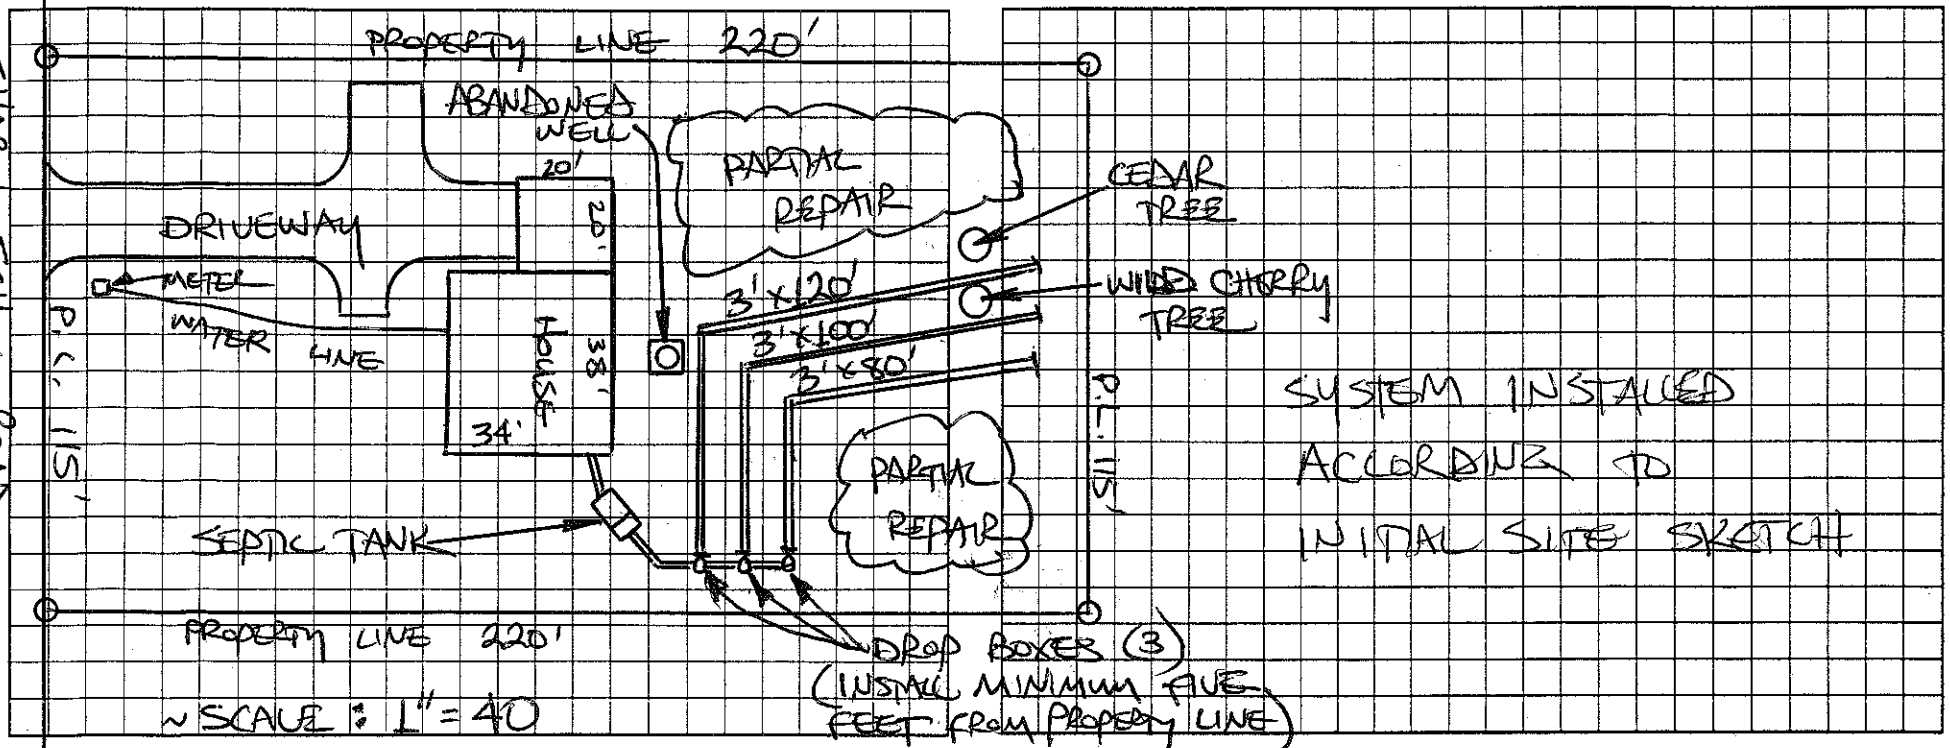


AS BUILT SKETCH

SYSTEM INSTALLED ACCORDING TO INITIAL SITE SKETCH

Permit can be suspended or revoked if any false information is supplied toward securing the permit/any unauthorized changes are made to the site/any unauthorized changes are made in the installation of the system. Improvement Permit with plat valid without expiration. Improvement Permit with site plan valid for sixty months. Authorization to Construct is valid for a period equal to that of Improvement Permit – not to exceed sixty months.

Signed: Johnny D Wilhelm date 7-5-06 Installed by: A-1 BACKHOE

Improvement Permit by: STEVE HEDRICK date 7-6-06 Operation Permit by: STEVE HEDRICK date 8-30-06

Authorization to Construct by: STEVE HEDRICK date 7-5-06 Existing System Inspection by: _____ date _____

HEALTH DEPT. COPY: WHITE OWNER COPY (FINAL): YELLOW OWNER COPY (INITIAL): PINK