IREDELL COUNTY HEALTH DEPARTMENT

STATESVILLE 704-878-5305 (C1) MOORESVILLE 704-664-5281

IMPROVEMENT PERMIT / AUTHORIZATION TO CONSTRUCT / OPERATION PERMIT / EXISTING SYSTEM INSPECTION

PERMIT# 12727 PIN# 3783-89-9785 DATE 5-6-05

OWNER OR CONTRACTOR JIM WORKMAN PHONE: Business (704) 655-9543 Home

ADDRESS 151 WILLOW POND DR. MT. ULLA, NC 28125

LOCATION I-40 W TR SHARON SCHOOL RD PROPERTY ON RIGHT

SUBDIVISION SHARON TRACE BLOCK / SECTION LOT 4 LOT AREA 0.50 SITE CLASS. PS DESIGN FLOW 360 L.T.A.R. 0.30 GPD/FT²

Septic Tank: 1000 Gallons; STB 1012 Date 10-30-04
Pump Tank: Gallons; PT Date
Pump Make: Model Serial No.
Nitrification Field: No Fields 1 Square Feet 1200 Linear Feet 315
No Lines 6 Trench Width 36" Max Trench Bottom Depth 36" Gravel Depth N/A

☑ New System ☐ Repair System Type: I, II, III, IV, V, VI
System Description: GRAVITY 25% REDUCTION
Repair System Description: LPP [redacted]
Maintenance Agreement Required: ☐ Yes ☑ No


☑ House/Mod. Home No. Bedrooms 3
☐ Mobile Home No. Bathrooms
☐ Business No. Employees
☐ Other
☐ Slab ☑ Crawl Space ☐ Basement w/plumbing ☐ Basement wo/plumbing

Water Supply: ☐ Individual ☑ Public ☐ Community


Comments:/Conditions: (1) INSTALL LINES 36" MAX. ON CONTOUR (2) GRADE OFF BERM (3) FILL AND PACK OLD DRAINAGE PATTERN (4) MAINTAIN SETBACKS (5) MUST REROUTE DRAINAGE PATTERN VERY SHALLOW, NOT DEEP

Comments:/Conditions: (1) SYSTEM ALTERED WITH PRIOR HEALTH DEPARTMENT APPROVAL (2) SEPTIC TANK WITH MARKER INSTALLED USING "TUFFTITE" FILTER

INITIAL SITE SKETCH

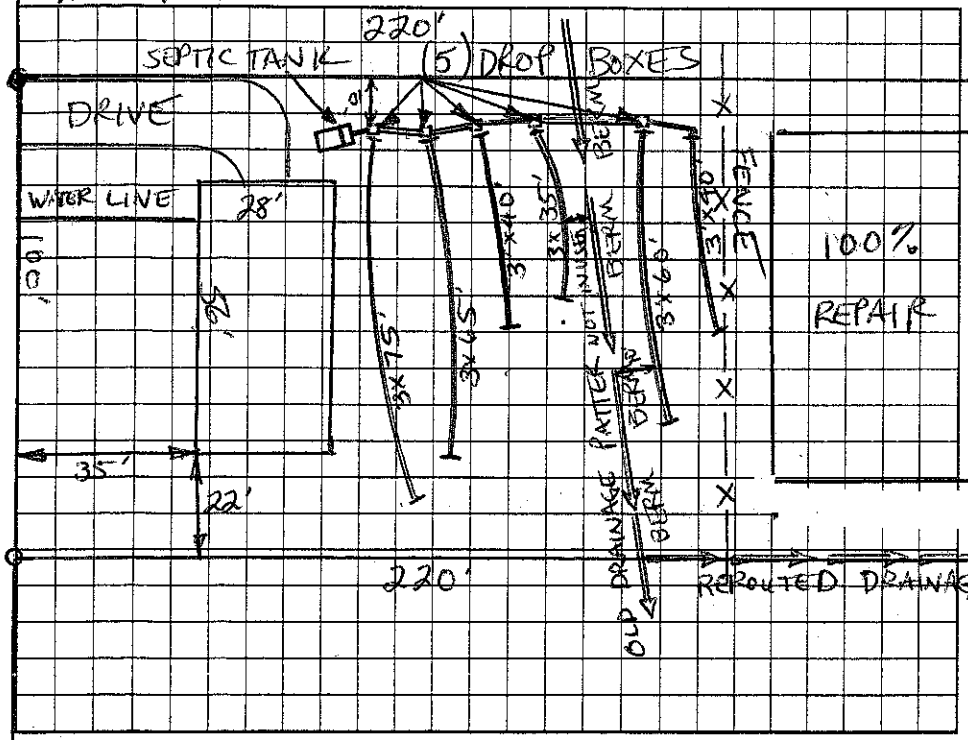

AS BUILT SKETCH

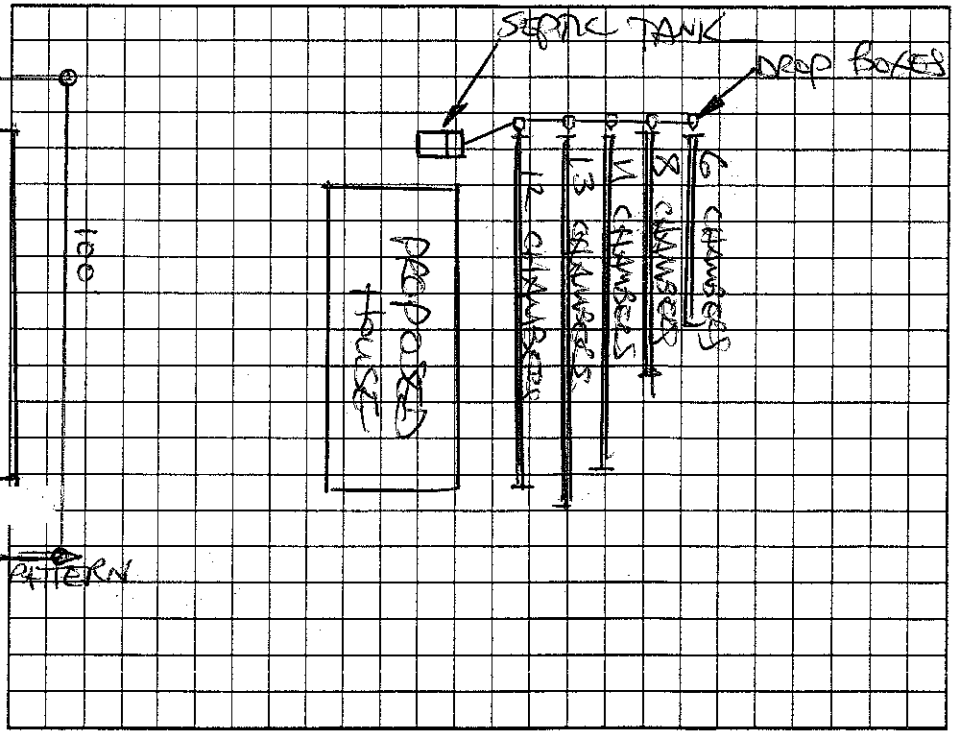

Permit can be suspended or revoked if any false information is supplied toward securing the permit/any unauthorized changes are made to the site/any unauthorized changes are made in the installation of the system. Improvement Permit with plat valid without expiration. Improvement Permit with site plan valid for sixty months. Authorization to Construct is valid for a period equal to that of Improvement Permit – not to exceed sixty months.

Signed: Dennis Galliher date 5-9-05 Installed by: A-1 BACKHOE

Improvement Permit by: Christopher M. Sherrill RS, CSS date 5-6-05 Operation Permit by: STEVE HENDRICK date 5-09-05

Authorization to Construct by: Christopher M. Sherrill RS, CSS date 5-9-05 Existing System Inspection by: date

HEALTH DEPT. COPY: WHITE OWNER COPY (FINAL): YELLOW OWNER COPY (INITIAL): PINK