IREDELL COUNTY HEALTH DEPARTMENT

STATESVILLE 704-878-5305 MOORESVILLE 704-664-5281

IMPROVEMENT PERMIT / AUTHORIZATION TO CONSTRUCT / OPERATION PERMIT / EXISTING SYSTEM INSPECTION

PERMIT# 126132 PIN# 3783-89-9834 DATE 3-1-05

OWNER OR CONTRACTOR DAVID MEEHAN PHONE: Business (704) 902-0286 Home

ADDRESS 105 GALAX DRIVE STATESVILLE NC 28677

LOCATION I-40 W TR SHARON SCHOOL RD (EXIT 141) LOT ON RIGHT APPROX. 2 MILES FROM EXIT

SUBDIVISION SHARON TRACE BLOCK / SECTION LOT 5 LOT AREA 0.505 SITE CLASS. PS DESIGN FLOW 360 L.T.A.R. 0.30 gpd/ft²

Septic Tank: 1000 Gallons; STB 1012 Date 11/27/05

Pump Tank: Gallons; PT EXISTING Date

Pump Make: Model WELL Serial No.

Nitrification Field: No Fields 1 Square Feet 1200 Linear Feet 200

No Lines 4 Trench Width 24" Max Trench Bottom Depth 36" Gravel Depth 24" SAND

☒ New System ☐ Repair System Type: I, II, III, IV, V, VI

System Description: GRAVITY PANEL 50% REDUCTION

Repair System Description: LP PANEL 50% REDUCTION

Maintenance Agreement Required: ☐ Yes ☒ No

☒ House/Mod. Home No. Bedrooms 3

☐ Mobile Home No. Bathrooms

☐ Business No. Employees

☐ Other

Water Supply: ☐ Individual ☒ Public ☐ Community


☐ Slab ☒ Crawl Space ☐ Basement w/plumbing ☐ Basement wo/plumbing

Comments:/Conditions: ① INSTALL TOTAL OF 44 PANELS ON CONTOUR ② RAKE & LIME TRENCH WALLS ③ MAINTAIN SETBACKS


Comments:/Conditions: - USED TUFF TIGHT FILTER

1"=40'

INITIAL SITE SKETCH

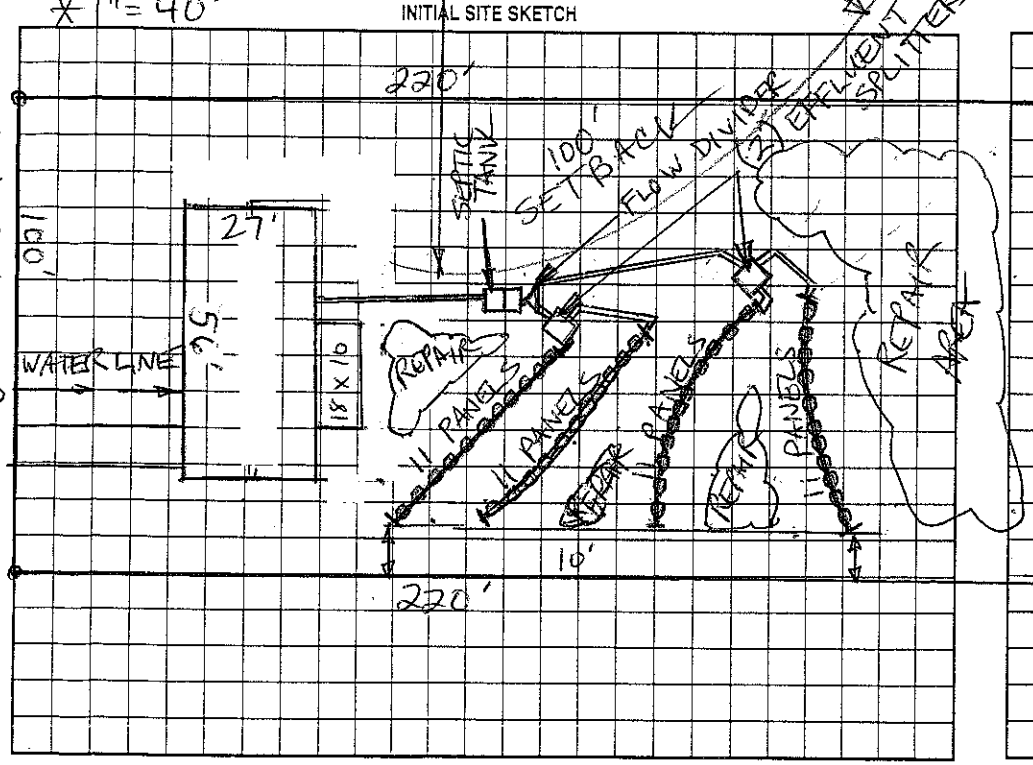

AS BUILT SKETCH

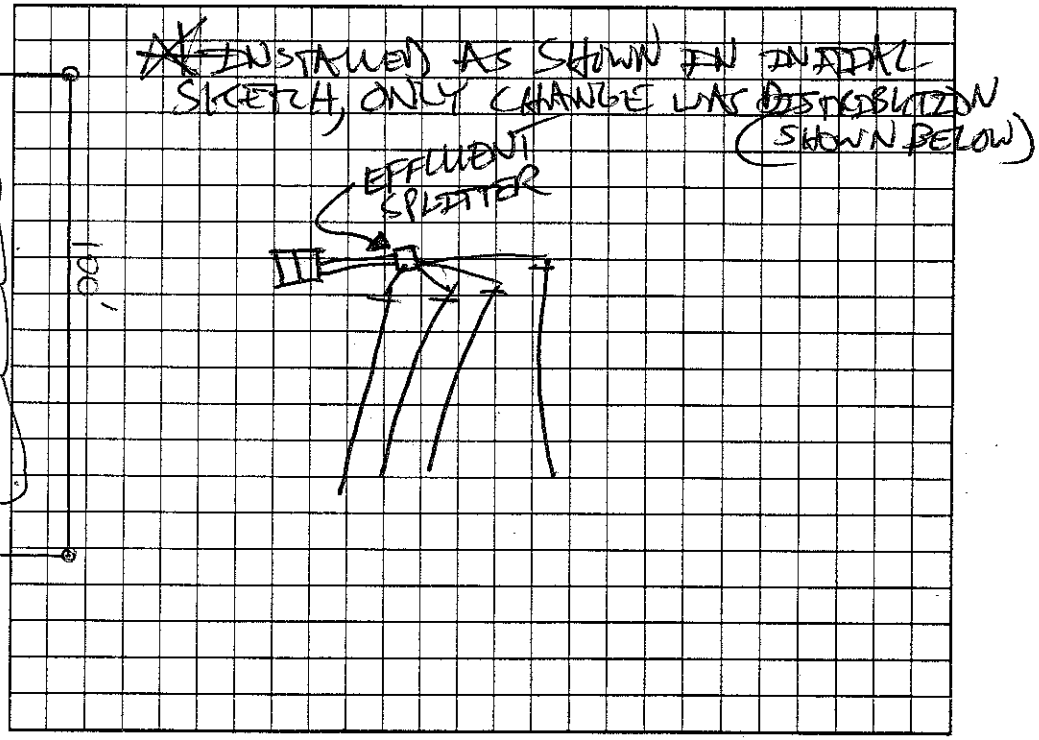

Permit can be suspended or revoked if any false information is supplied toward securing the permit/any unauthorized changes are made to the site/any unauthorized changes are made in the installation of the system. Improvement Permit with plat valid without expiration. Improvement Permit with site plan valid for sixty months. Authorization to Construct is valid for a period equal to that of Improvement Permit – not to exceed sixty months.

Signed: David Meehan date

Improvement Permit by: Christopher M. Sherrill PS, LSS date 3-1-05

Authorization to Construct by: Christopher M. Sherrill PS, LSS date 3-1-05

Installed by: A-1 BACKHOE

Operation Permit by: [signature] date 06/16/06

Existing System Inspection by: date

HEALTH DEPT. COPY: WHITE OWNER COPY (FINAL): YELLOW OWNER COPY (INITIAL): PINK