IREDELL COUNTY HEALTH DEPARTMENT

STATESVILLE 704-878-5305 MOORESVILLE 704-664-5281

IMPROVEMENT PERMIT / CERTIFICATE OF COMPLETION / OPERATION PERMIT / EXISTING SYSTEM INSPECTION

PROPERTY DESCRIPTION NO. Repair DATE 6-15-93 TAX MAP NO. Repair

OWNER OR CONTRACTOR Cleo Miller PHONE: Business Home 872-5885

ADDRESS

LOCATION I-40 W TR Sharon School Rd 4th house on L

SUBDIVISION NA BLOCK / SECTION LOT LOT AREA 3.0 acres SITE CLASS. Existing L.T.A.R. →

Water Supply: ☑ Individual ☐ Community ☐ Public Well

Septic Tank: Existing Gallons; STB — Date —

Pump Tank: — Gallons; PT — Date —

Nitrification Field: No Fields 2 Square Feet 600 Linear Feet 200'

No Lines 2 Trench Width 36" Trench Depth 24"-36" Gravel Depth 12"

☐ New System ☑ Repair System Type: I (II) II, IV, V, VI

System Description: Conventional, gravity

Repair System Description:

Maintenance Agreement Required: ☐ Yes ☑ No

☑ House/Mod. Home ☐ Mobile Home ☐ Business ☐ Other

No. Bedrooms 2 No. Bathrooms 1 No. Employees —

☐ Slab ☐ Crawl Space ☐ Basement w/plumbing ☑ Basement wo/plumbing

Garbage Disposal: ☐ Yes ☑ No


Auto. Dishwasher: ☐ Yes ☑ No

Auto. Washing Machine: ☑ Yes ☐ No


Other

Comments System (repair) turned down on 1st inspection, lines had 4' of fall. Took Pipe and gravel out of turned down lines and dug new repair lines in different area. Drain lines finaled 6-15-93. Washing machine and sink drains still have to be plumbed in to tank. → (Plumbed into tank 6-18-93)

INITIAL SITE SKETCH

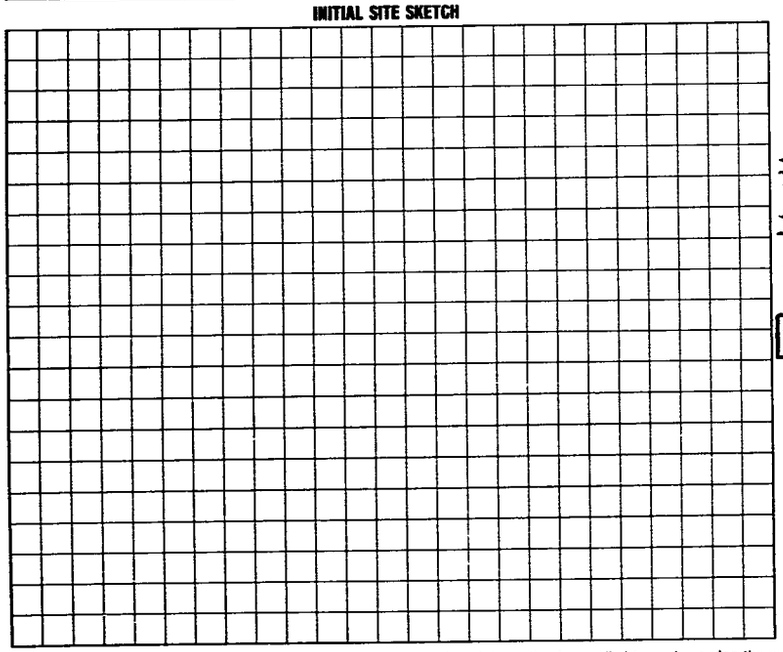

AS BUILT SKETCH

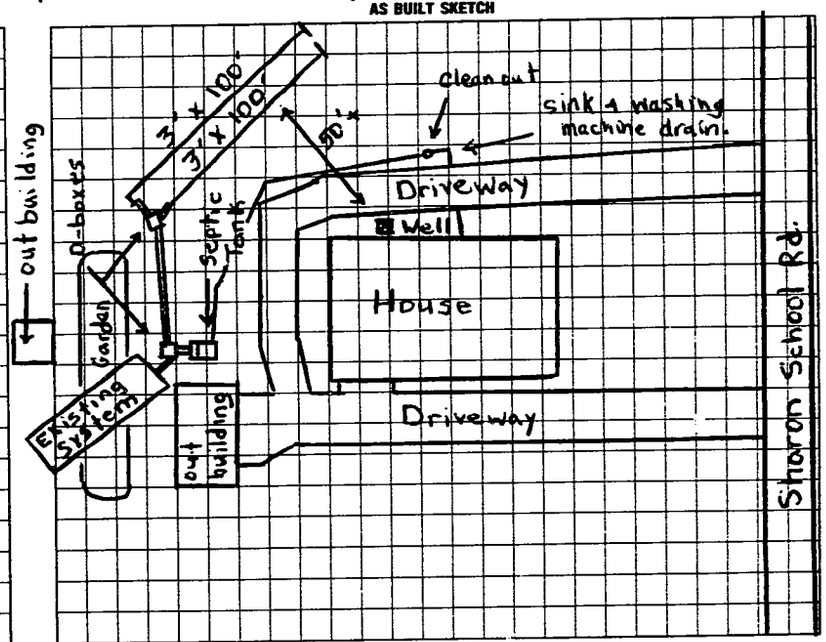

I understand that this permit can be suspended or revoked if any false information is supplied toward securing the permit/any unauthorized changes are made to the site/any unauthorized changes are made in the installation of the system. Improvement Permit is valid for 60 months from date of issuance.

Signed:

Improvement Permit by: Michael J. Dennis date 5-20-93

Existing System Inspection by: date

Installed by: Mike Benfield Co.

Certificate of Completion by: Michael J. Dennis date 6-18-93

Operation Permit by: date

HEALTH DEPT. COPY: WHITE INSPECTION COPY (FINAL): GREEN OWNER COPY (FINAL): YELLOW INSPECTION COPY (INITIAL): PINK OWNER COPY (INITIAL): GOLD