IREDELL COUNTY HEALTH DEPARTMENT

STATESVILLE 704-878-5305 MOORESVILLE 704-664-5281

IMPROVEMENT PERMIT / AUTHORIZATION TO CONSTRUCT / OPERATION PERMIT / EXISTING SYSTEM INSPECTION

PERMIT# 123075 PIN# 3783-99-0598 902-0574 DATE 8/4/04

OWNER OR CONTRACTOR Marvin Hendricks PHONE: Business — Home (704) 872-5295

ADDRESS 346 New Sterling Road Stony Point, NC 28678

LOCATION I-40W, (R) Sharon School Rd past 1st brick home on right

SUBDIVISION Shaun Trace BLOCK / SECTION — LOT 2 LOT AREA 1.62 SITE CLASS PS DESIGN FLOW 360 L.T.A.R. .30 g/sf

Septic Tank: 4000 Gallons; STB 1012 Date 6-7-04
Pump Tank: — Gallons; PT — Date —
Pump Make: — Model — Serial No. —
Nitrification Field: No Fields 1 Square Feet eq to 1200 Linear Feet 300
No Lines 4@ 75' Trench Width 36" Max Trench Bottom Depth 30" Gravel Depth N/A

☒ New System ☐ Repair System Type: I, II, (III) IV, V, VI
System Description: Gravity, 25% reduction
Repair System Description: Pump LPP
Maintenance Agreement Required: ☐ Yes ☒ No


☒ House/Mod. Home No. Bedrooms 3
☐ Mobile Home No. Bathrooms —
☐ Business No. Employees —
☐ Other —
☐ Slab ☒ Crawl Space ☐ Basement w/plumbing ☐ Basement wo/plumbing

Water Supply: ☐ Individual ☒ Public ☐ Community


Comments/Conditions: ① Install Sub surface drainage 42" to daylight as shown

Comments/Conditions: TUFFTITE EFFLUENT MARKER V'D LINES STAKING WELLS F/D V'D 11-1-04 INSTALLED DURING WET SOIL CONDITIONS

INITIAL SITE SKETCH

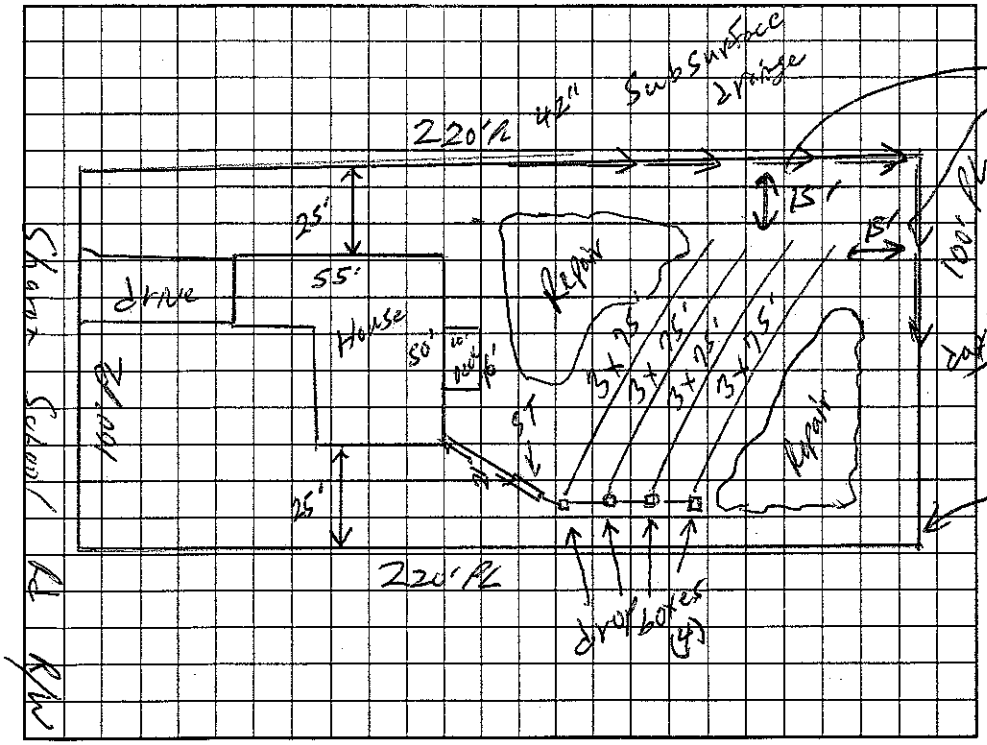

AS BUILT SKETCH

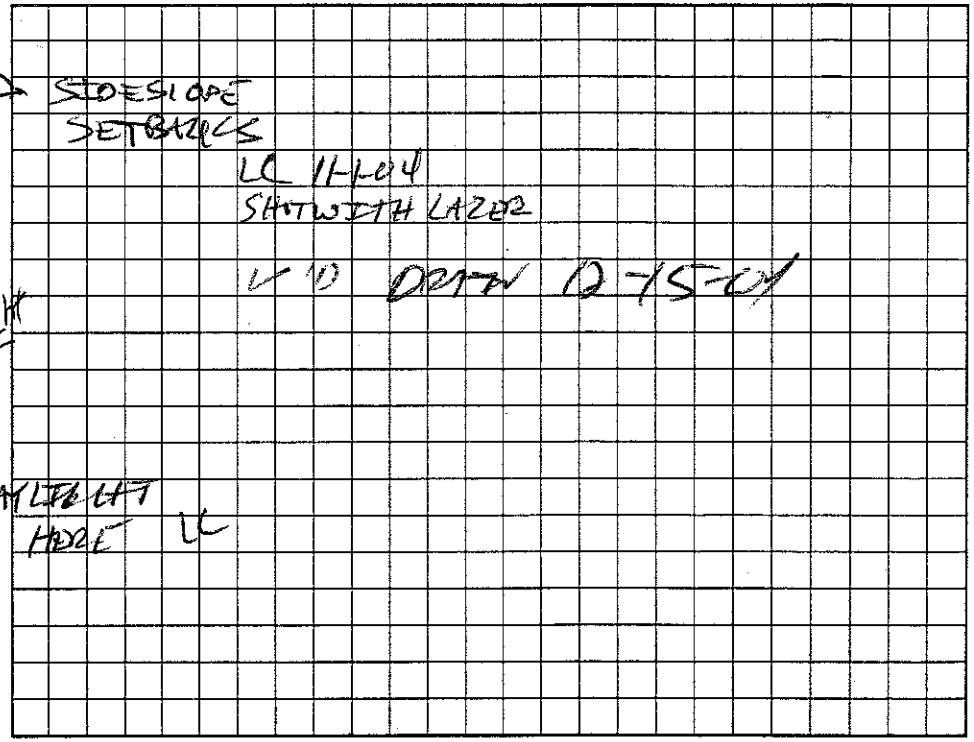

Permit can be suspended or revoked if any false information is supplied toward securing the permit/any unauthorized changes are made to the site/any unauthorized changes are made in the installation of the system. Improvement Permit with plat valid without expiration. Improvement Permit with site plan valid for sixty months. Authorization to Construct is valid for a period equal to that of Improvement Permit – not to exceed sixty months.

Signed: Marty Hendricks date 8-05-04 Installed by: ESLAC DLOG

Improvement Permit by: William O. Johnson date 8/4/04 Operation Permit by: [illegible] date 12-15-04

Authorization to Construct by: William O. Johnson date 8/4/04 Existing System Inspection by: — date —

HEALTH DEPT. COPY: WHITE OWNER COPY (FINAL): YELLOW OWNER COPY (INITIAL): PINK