IREDELL COUNTY HEALTH DEPARTMENT

Statesville Office (704) 878-5305 Mooresville Office (704) 660-3625 PERMIT # 215/22

IMPROVEMENT PERMIT / AUTHORIZATION TO CONSTRUCT / OPERATION PERMIT / EXISTING SYSTEM

PIN # 3784258818

APPLICANT: James Hines APPLICANT ADDRESS: 374 Gun Club Rd.

SITE ADDRESS: 374 Gun Club Rd. PHONE: 704-657-1479 ALT. PHONE: N/A

SITE DIRECTIONS: I-40 W to Sharon School Rd. TR Sharon School TL Gun Club Property @ End of Rd.

SUBDIVISION: N/A SECTION: N/A LOT # N/A LOT AREA: 0.86 acres DESIGN FLOW: 240gpd L.T.A.R.: Existing


Septic Tank	Existing (gal)	STB	Date	☐ New System ☐ Repair ☐ Expansion	System Type: I (II) III IV V VI	☑ Residence	No. Bedrooms 2
Pump Tank	(gal)	PT	Date	System Description:	Existing	☐ Business	No. Persons 4
Pump Make		Model	Serial #	Repair System Description:		☐ Other	No. Employees
# Nitrification Fields	Ex	# Lines Ex	Linear Ft: Ex	Maintenance Agreement Required:	☐ YES ☑ NO	☐ Slab	☐ Crawl Space
Trench Width	Ex	Max. Trench Bottom Depth	Ex	Gravel Depth Ex	☐ GRAVITY ☐ PRESSURE	☑ Basement w/plumbing	☐ Basement w/o plumbing

Water Supply: ☑ Private ☐ Public ☐ Community


Comments / Conditions: - Remove existing house from property prior to connection new house to existing septic systems

Maintain a minimum of 25' between basement cut & existing septic repair area. Maintain a minimum of 10' between existing septic system & basement foundation.

INITIAL SITE SKETCH

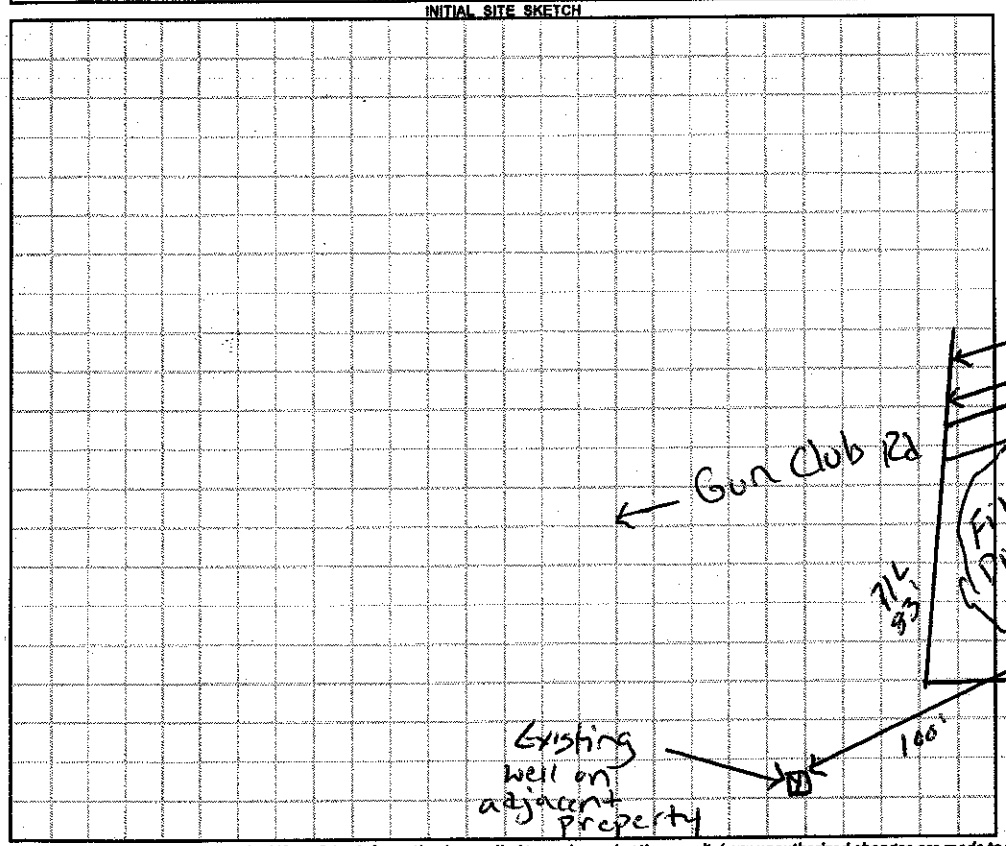

AS BUILT SKETCH

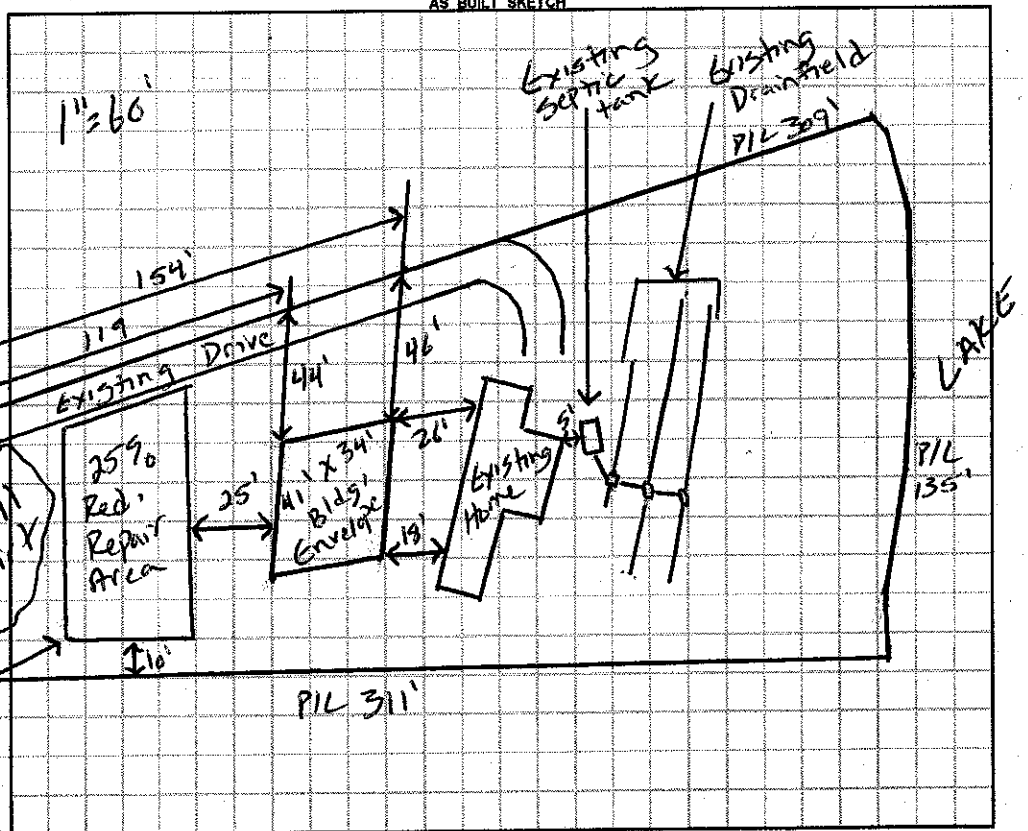

Permit can be suspended or revoked if any false information is supplied toward securing the permit / any unauthorized changes are made to the site / any unauthorized changes are made in the installation of the system. **CONTACT A LOCATOR SERVICE PRIOR TO ANY EXCAVATION**


☐ **IMPROVEMENT PERMIT** *with plat valid without expiration.* ☐ **IMPROVEMENT PERMIT** *with site plan valid for 60 mos.* ☐ **AUTHORIZATION TO CONSTRUCT** *valid for period equal to IMPROVEMENT PERMIT--not to exceed 60 mo.*

Owner / Applicant Signature: James W Hines Date: 12-30-15 Installed by:

IMPROVEMENT PERMIT by: Date: OPERATION PERMIT by: Date:

AUTHORIZATION TO CONSTRUCT by: Date: Existing System Inspected by: Justin Henderson Date: 12-30-15

Health Dept. Copy - WHITE Applicant (Final Approval) - YELLOW Applicant (Conditional Approval) - PINK

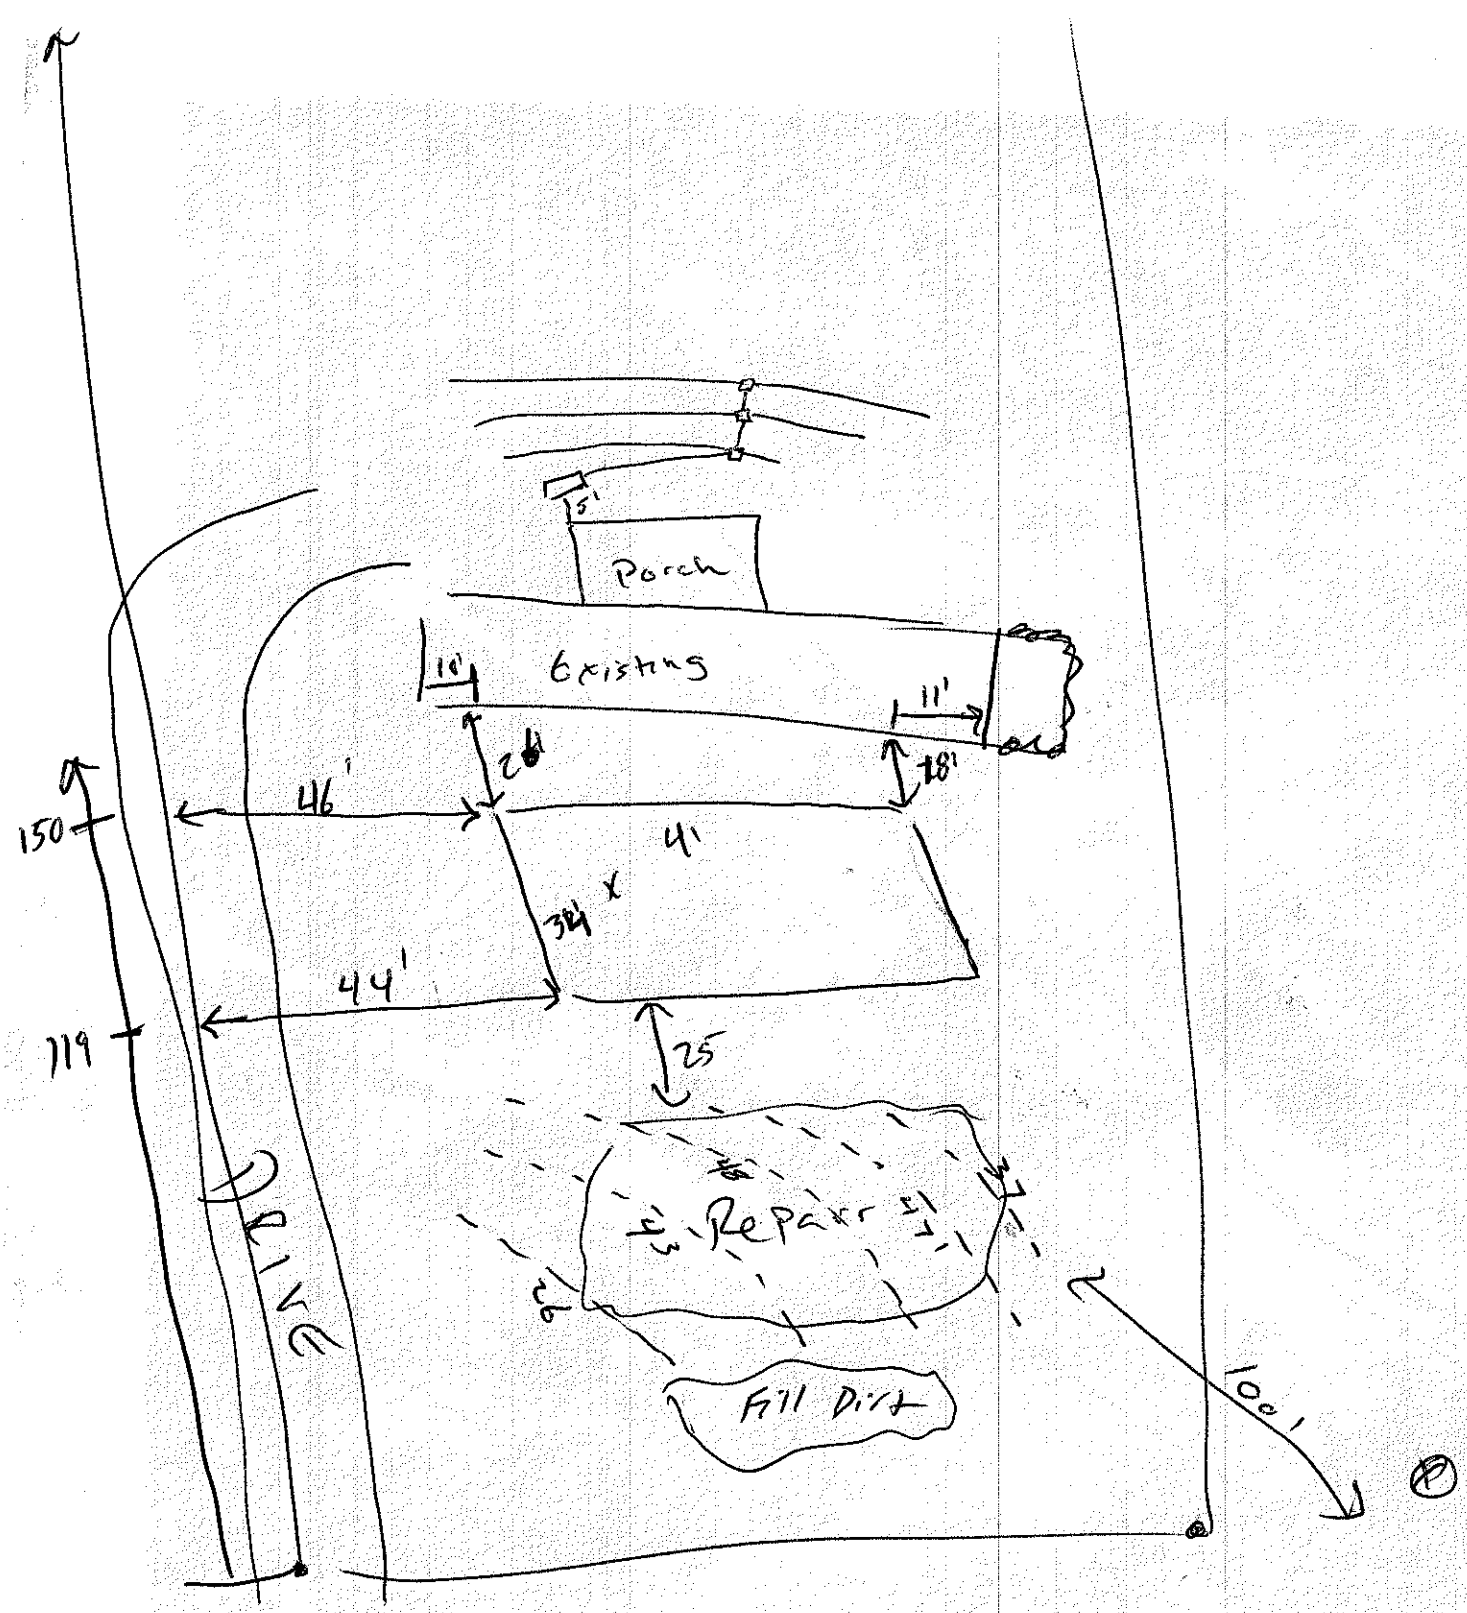
5'
Porch
10'
Existing
11'
18'
20'
46'
150'
41'
38'
X
44'
119'
25
Repair
20'
Fill Dirt
Road
Lot
N