1:00

FP #365 5-27-11

IREDELL COUNTY HEALTH DEPARTMENT - *ENVIRONMENTAL HEALTH* ☑ STATESVILLE OFFICE 704-878-5305 ☐ MOORESVILLE OFFICE 704-664-5281

IMPROVEMENT PERMIT / AUTHORIZATION TO CONSTRUCT / OPERATION PERMIT / EXISTING SYSTEM INSPECTION

PERMIT # 166351 PIN # 3784 ~~25 [illegible]~~ 26-7116 DATE 24 May 2011

OWNER Dana Harvey APPLICANT: Tim Abee (Contractor) PHONE: Home/Cell # (336) 492-2089 Business #

SITE ADDRESS 176 Gun Club Rd. Stony Point OWNER / APPLICANT ADDRESS


SITE DIRECTIONS I-40 W TR Sharon Schad Rd. TL Gun Club Rd. - Property on Rt.

SUBDIVISION BLOCK / SECTION LOT # LOT AREA 5.94 ac. DESIGN FLOW 360 g/d L.T.A.R. 0.3 g/ft²/d

Septic Tank	Exist.	Gallons: STB		Date	☐ New System	☐ Repair	☑ Expansion System	Type I II (III) IV V VI	☑ Residence	No. Bedrooms 3	Water Supply
Pump Tank		Gallons: P T		Date	System Description:	25% Red			☐ Business	No. Persons	☑ Private
Pump Make		Model		Serial #	Repair System Description:	Conventional w/ 25% Reduction			☐ Other	No. Employees	☐ Public
No. Nitrification Fields:	1	No. Lines	1	Linear Feet 100'	Maintenance Agreement Required	☐ YES	☑ NO		☐ Slab	☑ Crawl Space	☐ Community
Trench Width	36"	Max. Trench Bottom Depth	36"	Gravel Depth NA	☑ GRAVITY	☐ PRESSURE			☐ Basement w/plumbing	☐ Basement w/o plumbing	

Comments / Conditions * Keep Building Foundation 25'+ from existing well.

INITIAL SITE SKETCH

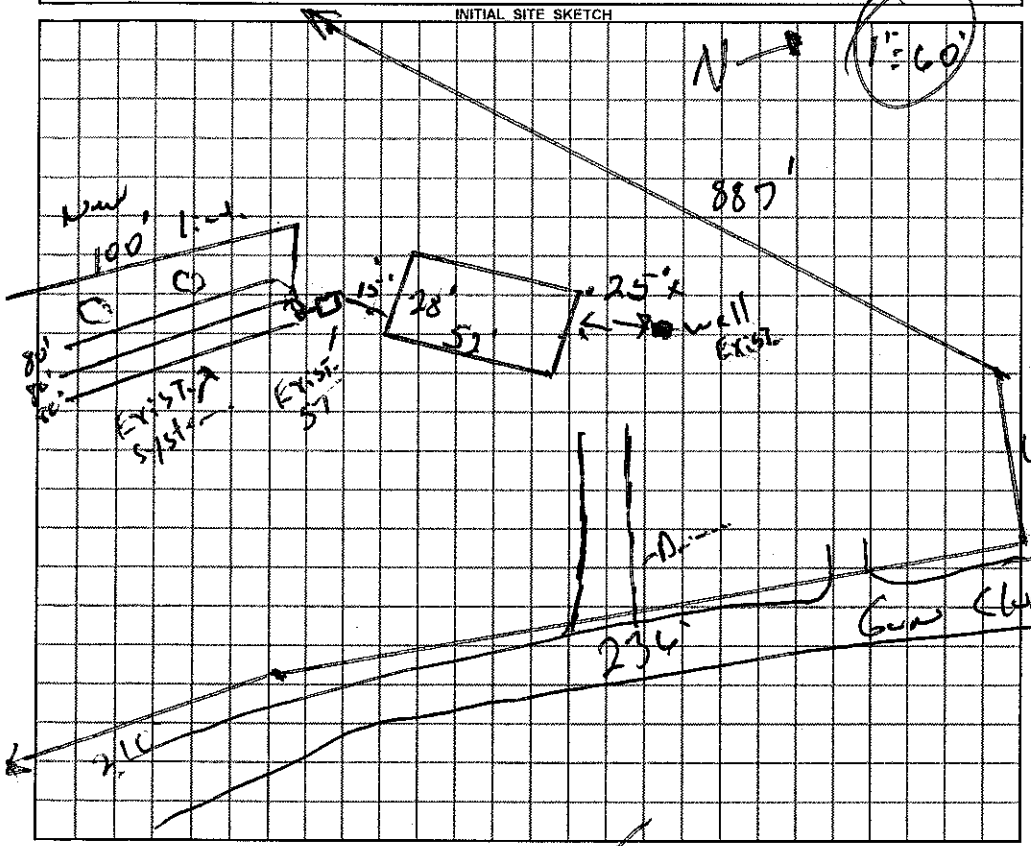

AS BUILT SKETCH

Permit can be suspended or revoked if any false information is supplied toward securing the permit / any unauthorized changes are made to the site / any unauthorized changes are made in the installation of the system.

☐ *IMPROVEMENT PERMIT* with plat valid without expiration. ☑ *IMPROVEMENT PERMIT* with plat valid without expiration. site plan valid 60 mo. ☑ *AUTHORIZATION TO CONSTRUCT* valid for period equal to IMPROVEMENT PERMIT–not to exceed 60 mo.

Owner / Applicant Signature: Dana Abee Date 5/27/11 Installed by: Abee Grading

IMPROVEMENT PERMIT by: REHS Date 25 May 11 OPERATION PERMIT by: REHS Date 7-21-11

AUTHORIZATION TO CONSTRUCT by: REHS Date 25 May 11 Existing System Inspected by: REHS Date

YOU SHOULD CONTACT A LOCATOR SERVICE PRIOR TO ANY EXCAVATION

White Copy – Environmental Health YELLOW COPY (Final) Owner / Applicant PINK COPY (Initial) Owner / Applicant