IREDELL COUNTY HEALTH DEPARTMENT

Statesville Office (704) 878-5305 Mooresville Office (704) 660-3625 PERMIT # 211431

IMPROVEMENT PERMIT / AUTHORIZATION TO CONSTRUCT / OPERATION PERMIT / EXISTING SYSTEM

PIN # 3784295074

APPLICANT: Clayton Homes/Joe Estes APPLICANT ADDRESS: 2026 Northside Dr. Statesville, NC 28677

SITE ADDRESS: 1340 Sharon School Rd Stony Point, NC PHONE: ALT. PHONE:

SITE DIRECTIONS: I-40 W TR Sharon School Rd approx. 4 miles on right


SUBDIVISION: — SECTION: — LOT # 1 LOT AREA: .79 Acres DESIGN FLOW: 480gpd L.T.A.R.: .3

Septic Tank	1000 (gal)	STB	760	Date	12-29-15	☒ New System	☐ Repair	☐ Expansion	System Type: I II III IV V VI	☒ Residence	No. Bedrooms 4
Pump Tank	N/A (gal)	PT	N/A	Date	N/A	System Description:	Gravity - 25% Reduction			☐ Business	No. Persons 8
Pump Make	N/A	Model	Poly IV	Serial #	PL-68	Repair System Description:	Same			☐ Other	No. Employees
# Nitrification Fields	1	# Lines	6	Linear Ft:	min. 400 ft	Maintenance Agreement Required:	☐ YES	☒ NO		☐ Slab	☒ Crawl Space
Trench Width	36"	Max. Trench Bottom Depth	30"	Gravel Depth	N/A		☒ GRAVITY	☐ PRESSURE		☐ Basement w/plumbing	☐ Basement w/o plumbing


Water Supply: ☐ Private ☒ Public ☐ Community

Comments / Conditions: OK to feather out old perms. Keep Septic at least 10ft to PL & minimum 5ft from House (including decks & porches)

INITIAL SITE SKETCH

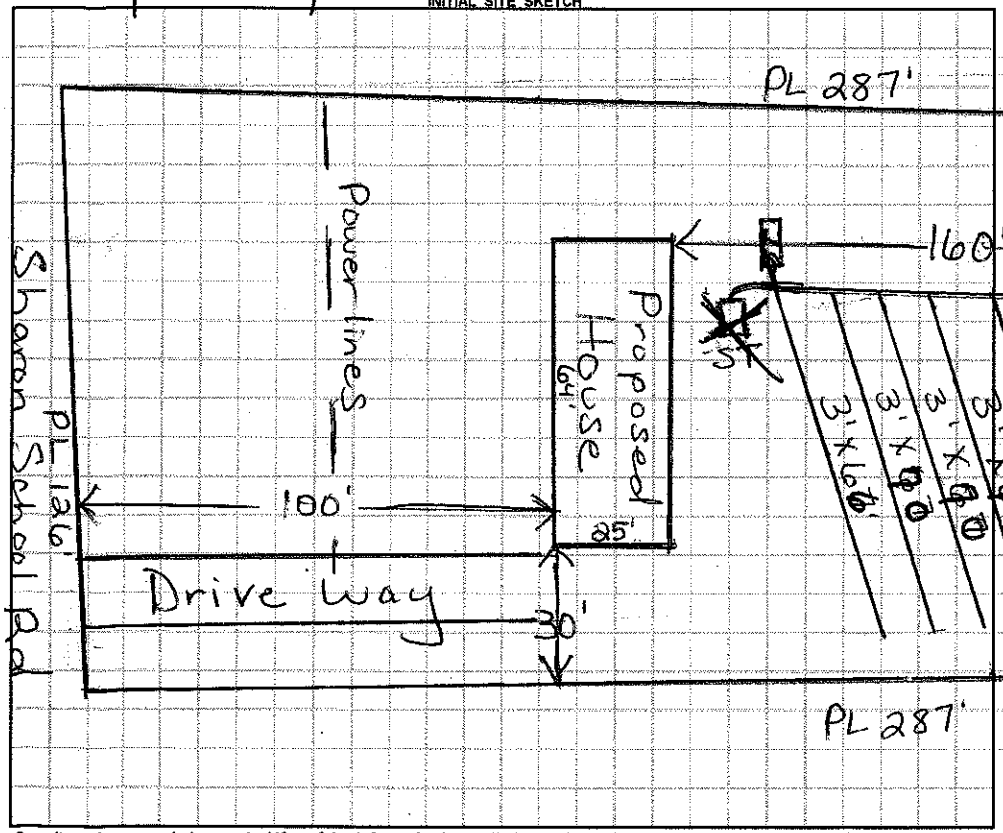

AS BUILT SKETCH

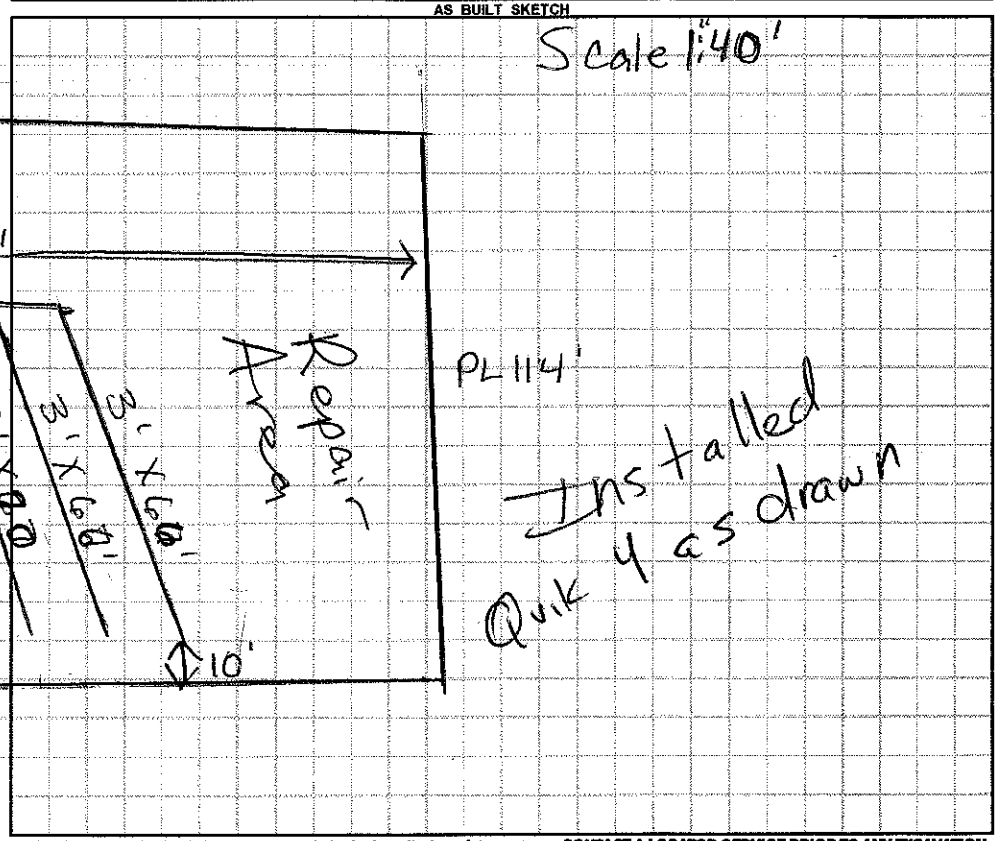

Permit can be suspended or revoked if any false information is supplied toward securing the permit / any unauthorized changes are made to the site / any unauthorized changes are made in the installation of the system. **CONTACT A LOCATOR SERVICE PRIOR TO ANY EXCAVATION**

☐ **IMPROVEMENT PERMIT** *with plat valid without expiration.* ☒ **IMPROVEMENT PERMIT** *with site plan valid for 60 mos.* ☒ **AUTHORIZATION TO CONSTRUCT** *valid for period equal to IMPROVEMENT PERMIT--not to exceed 60 mo.*

Owner / Applicant Signature: Date: 8/3/15 Installed by: Bryants Contracting

IMPROVEMENT PERMIT by: Maria H. Dotson RS Date: 7/30/15 OPERATION PERMIT by: Date: 03/17/16

AUTHORIZATION TO CONSTRUCT by: Maria H. Dotson RS Date: 7/30/15 Existing System Inspected by: Date:

Health Dept. Copy - WHITE Applicant (Final Approval) - YELLOW Applicant (Conditional Approval) - PINK