IREDELL COUNTY HEALTH DEPARTMENT

STATESVILLE 704-878-5305 MOORESVILLE 704-664-5281

IMPROVEMENT PERMIT / AUTHORIZATION TO CONSTRUCT / OPERATION PERMIT / EXISTING SYSTEM INSPECTION

PERMIT# 88198 PIN# 3784600150 pt DATE March 30, 2000

OWNER OR CONTRACTOR Fred Hefner PHONE: Business Home 704 256-9487

ADDRESS 6265 Oxford School Rd Claremont NC

LOCATION 40W (R) Sharon School Rd past Sharon School Groc. on Left Gun Club Rd (Apx 3 mile) Lt located on left N/100 ft

SUBDIVISION BLOCK / SECTION LOT LOT AREA 20 Ac. SITE CLASS PS DESIGN FLOW 360 L.T.A.R. .025

Septic Tank: 1000 Gallons; STB 786 Date 3-22-00

Pump Tank: Gallons; PT Date

Pump Make: Model Serial No.

Nitrification Field; No Fields 1 Square Feet 1440 Linear Feet 480

No Lines 4 Trench Width 36 Max Trench Bottom Depth 30-36" Gravel Depth 12"

☒ New System ☐ Repair System Type: I. (II) III. IV. V. VI

System Description: Conventional Gravity

Repair System Description: Same

Maintenance Agreement Required: ☐ Yes ☒ No

☒ House/Mod. Home No. Bedrooms 3

☐ Mobile Home No. Bathrooms 2

☐ Business No. Employees

☐ Other


☐ Slab ☐ Crawl Space ☐ Basement w/plumbing ☒ Basement wo/plumbing

Water Supply: ☒ Individual ☐ Public ☐ Community — Well


Comments/Conditions: Install system on contour. Install interceptor drain around septic system may in corporate basement/foundation drain into this drain. Interceptor drain 6" wide min. 52" deep, slotted corrugated pipe + Fill w/ gravel up to 6" of surface. Run to daylight.

Comments/Conditions: (Add (one) 120ft x 3' line for pool House -WOJ 5-30-01) *Call for inspection of interceptor drain. Call 928-2030 if any questions — Billy Lee Sitter

INITIAL SITE SKETCH

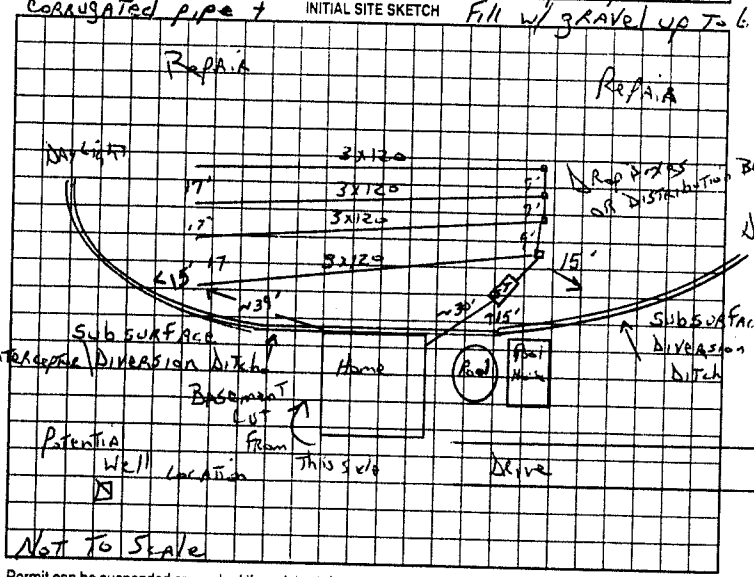

AS BUILT SKETCH

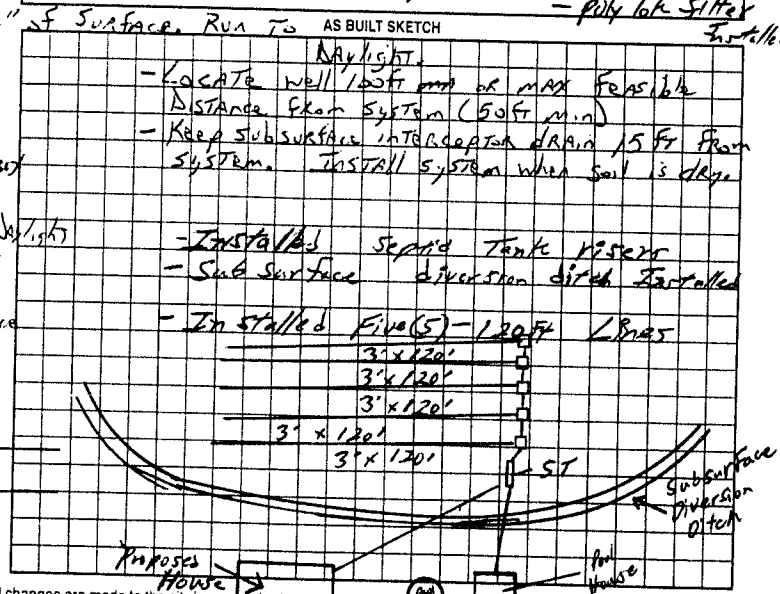

Permit can be suspended or revoked if any false information is supplied toward securing the permit/any unauthorized changes are made to the site/any unauthorized changes are made in the installation of the system. Improvement Permit with plat valid without expiration. Improvement Permit with site plan valid for sixty months. Authorization to Construct is valid for a period equal to that of Improvement Permit – not to exceed sixty months.

Signed: Fred Hef date 4-17-00 Installed by: Baker Land Scaping well

Improvement Permit by: J C Potter date March 30 2000 Operation Permit by: William O. Johnson date 6/1/01

Authorization to Construct by: J C Potter date March 30 2000 Existing System Inspection by: date

HEALTH DEPT. COPY: WHITE OWNER COPY (FINAL): YELLOW OWNER COPY (INITIAL): PINK