IREDELL COUNTY HEALTH DEPARTMENT

Statesville Office (704) 878-5305 Mooresville Office (704) 660-3625 PERMIT # 179573

IMPROVEMENT PERMIT / AUTHORIZATION TO CONSTRUCT / OPERATION PERMIT / EXISTING SYSTEM

PIN # 3784392021

APPLICANT: Lee Ann Estes Bettis APPLICANT ADDRESS: 91 Pengrove Dr

SITE ADDRESS: Sharon School Rd. PHONE: 704-682-3420 ALT. PHONE: N/A

SITE DIRECTIONS: I-40W to Sharon School Rd TR; Property on right ~ 3.5 miles

SUBDIVISION: N/A SECTION: N/A LOT # N/A LOT AREA: 10.01 acres DESIGN FLOW: 360 gpd L.T.A.R.: 0.3


Septic Tank	1000 (gal)	STB	1012-1000	Date	5-2-13	☑ New System	☐ Repair	☐ Expansion	System Type: I ☑ II III IV V VI	☑ Residence	No. Bedrooms 3
Pump Tank	(gal)	PT		Date		System Description:	Conventional			☐ Business	No. Persons
Pump Make		Model		Serial #		Repair System Description:	Conventional - Pump			☐ Other	No. Employees
# Nitrification Fields	1	# Lines	5	Linear Ft:	400	Maintenance Agreement Required:	☐ YES	☑ NO		☐ Slab	☑ Crawl Space
Trench Width	36"	Max. Trench Bottom Depth	36"	Gravel Depth	12"		☑ GRAVITY	☐ PRESSURE		☐ Basement w/plumbing	

Water Supply: ☐ Private ☑ Public ☐ Community


☐ Basement w/o plumbing

Comments / Conditions: Install a conventional system on contour with serial distribution using Drop boxes to connect the drainlines. An accepted system may also be installed.

INITIAL SITE SKETCH

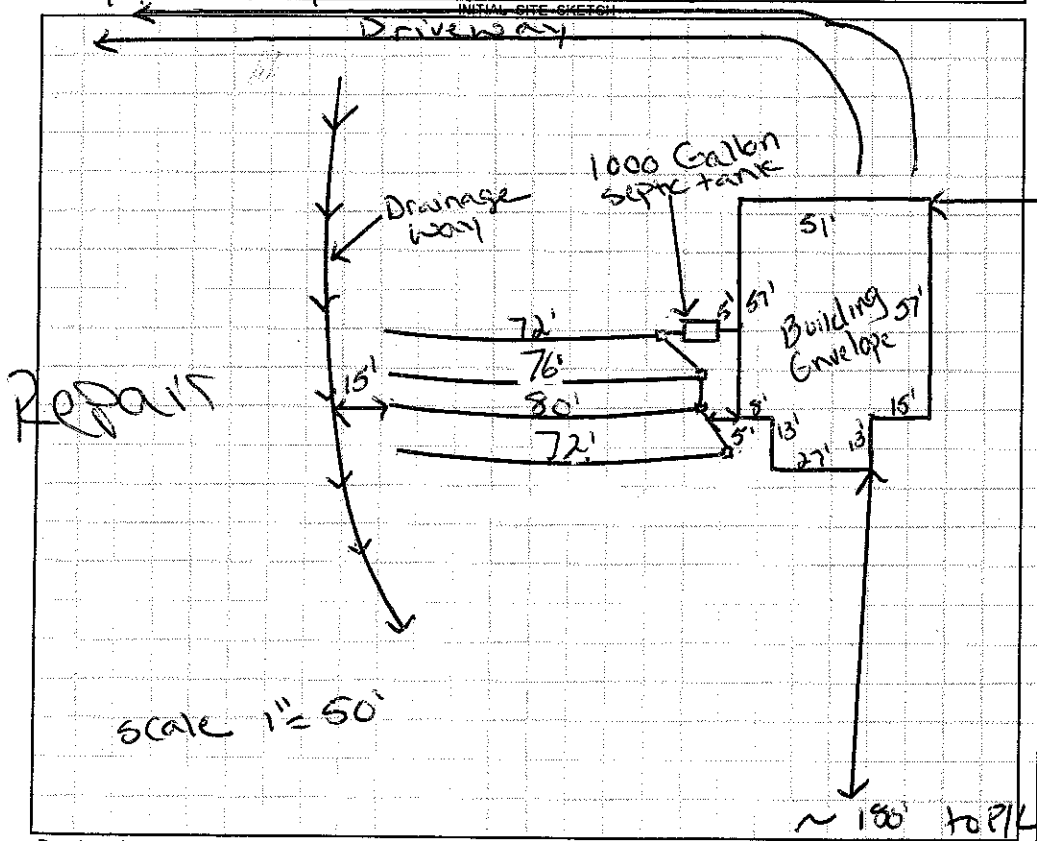

AS BUILT SKETCH

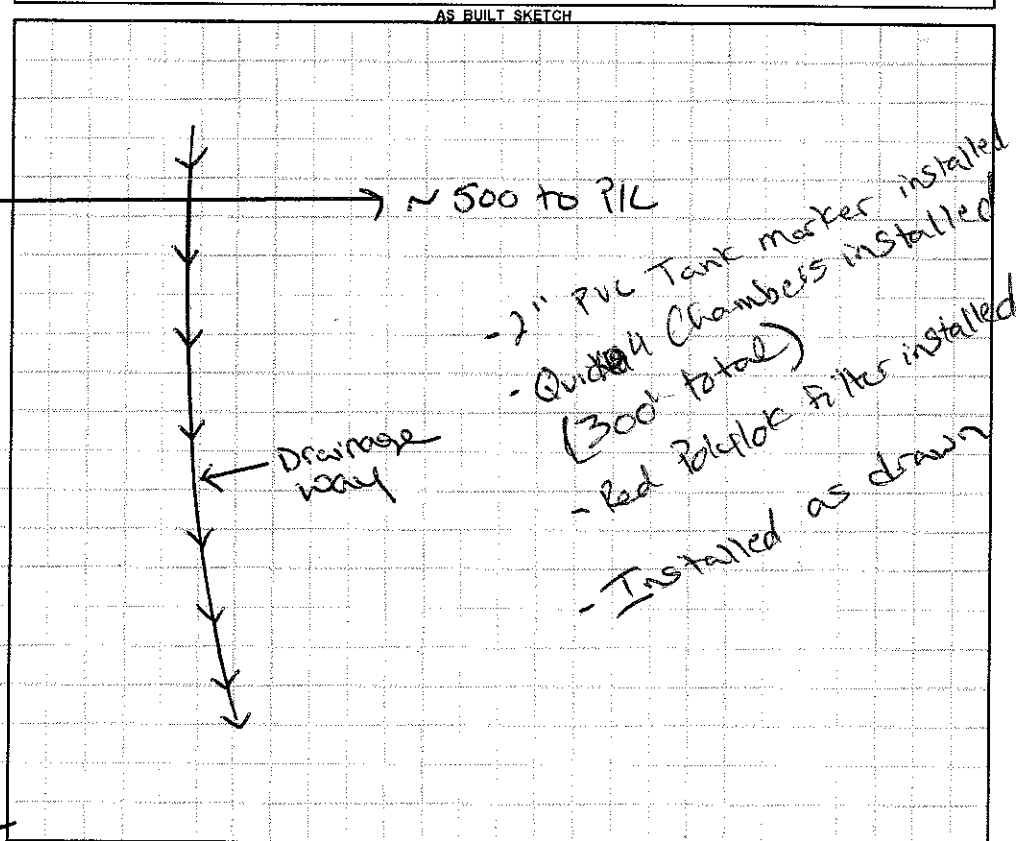

Permit can be suspended or revoked if any false information is supplied toward securing the permit / any unauthorized changes are made to the site / any unauthorized changes are made in the installation of the system. **CONTACT A LOCATOR SERVICE PRIOR TO ANY EXCAVATION**

☐ **IMPROVEMENT PERMIT** *with plat valid without expiration.* ☑ **IMPROVEMENT PERMIT** *with site plan valid for 60 mos.* ☑ **AUTHORIZATION TO CONSTRUCT** *valid for period equal to IMPROVEMENT PERMIT--not to exceed 60 mo.*

Owner / Applicant Signature: [signature] Date: 7-30-13 Installed by: Esker Elder

IMPROVEMENT PERMIT by: Justin Henderson Date: 7-19-13 OPERATION PERMIT by: Justin Henderson Date: 9-25-13

AUTHORIZATION TO CONSTRUCT by: Justin Henderson Date: 7-19-13 Existing System Inspected by: Date:

Health Dept. Copy - WHITE Applicant (Final Approval) - YELLOW Applicant (Conditional Approval) - PINK