IREDELL COUNTY HEALTH DEPARTMENT

STATESVILLE 704-878-5305 MOORESVILLE 704-664-5281

62221

IMPROVEMENT PERMIT / CERTIFICATE OF COMPLETION / OPERATION PERMIT / EXISTING SYSTEM INSPECTION

PROPERTY DESCRIPTION NO. ~~2405406333~~ DATE 7-5-96 TAX MAP NO. 8P-A-67 PT of Watershed: ☐ Yes ☐ No

OWNER OR CONTRACTOR Russell Henline PHONE: Business Home 873 8915

ADDRESS 2380 Island Ford Rd Statesville

LOCATION I-40 W TR Sharon School Rd TL Island Ford 1mi TR

SUBDIVISION BLOCK / SECTION Tract LOT LOT AREA 6.99 acres SITE CLASS PS DESIGN FLOW 240 L.T.A.R. 1.3

Septic Tank: 1500 Gallons; STB 1011 Date 1-21-97

Pump Tank: Gallons; PT Date

Pump Make: Model Serial No.

Nitrification Field: No Fields 1 Square Feet 810 Linear Feet 270

No Lines 3 Trench Width 36" Max Trench Bottom Depth 24" Gravel Depth 12"

☐ New System ☐ Repair System Type: I / II / III / IV / V / VI

System Description: Conv. Gravity

Repair System Description: Pump To conv. lines

Maintenance Agreement Required: ☐ Yes ☐ No

☐ Slab ☐ Crawl Space ☑ Basement w/plumbing ☐ Basement wo/plumbing

☑ House/Mod. Home No. Bedrooms 2

☐ Mobile Home No. Bathrooms 2

☐ Business No. Employees

☐ Other

Water Supply: ☑ Individual ☐ Community ☐ Public


Comments:

Shallow Soil Drain lines NO Deeper than 24"


Comments:

* Upper lines are Deep

INITIAL SITE SKETCH

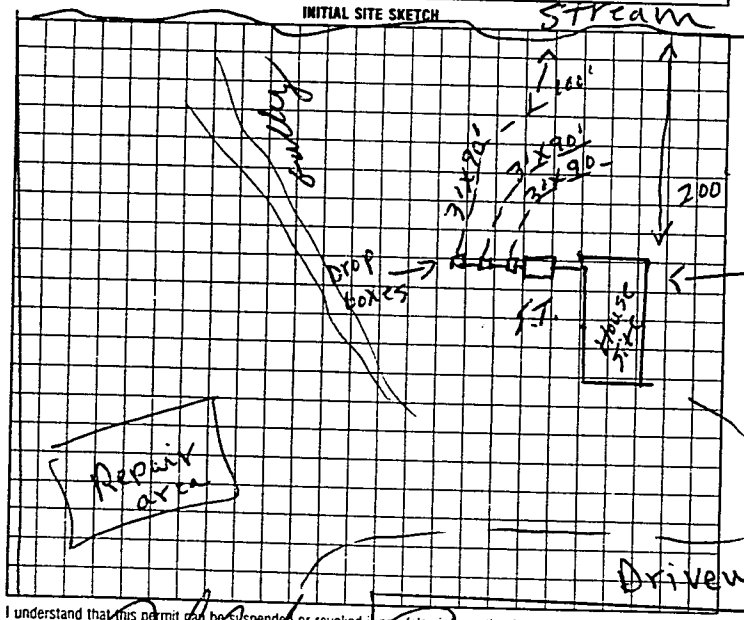

AS BUILT SKETCH

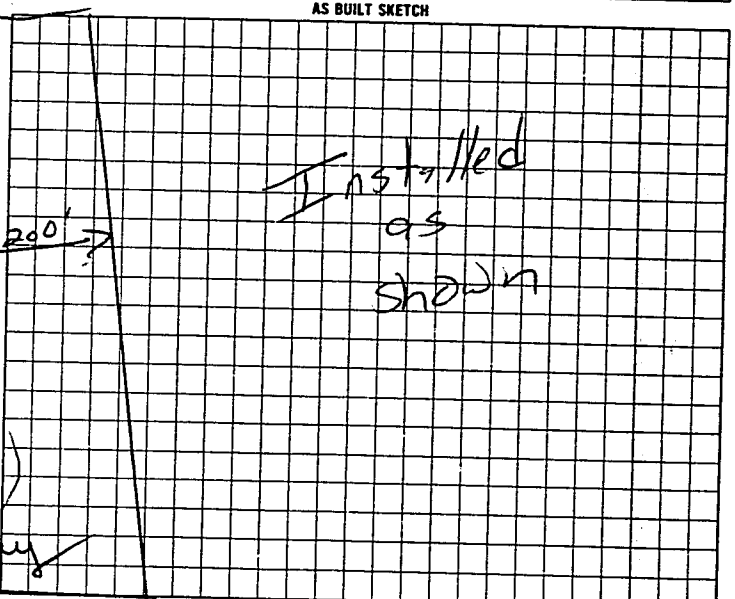

I understand that this permit can be suspended or revoked if any false information is supplied toward securing the permit/any unauthorized changes are made to the site/any unauthorized changes are made in the installation of the system.

Signed: John B. Henline Jr

Improvement Permit by: P.C. moore date 7-5-96

Existing System Inspection by: P.C. moore date 7-5-96

Authorization to cover

Installed by: Rich Shook

Certificate of Completion by: date

Operation Permit by: M.C.O.J RS date 6-5-97

HEALTH DEPT COPY WHITE INS. ECTION COPY (FINAL) GREEN OWNER COPY (FINAL) YELLOW INSPECTION COPY (INITIAL) PINK OWNER COPY (INITIAL) GOLD

+authorization to cover Expires 60 mos from issue

260108