IREDELL COUNTY HEALTH DEPARTMENT

STATESVILLE 704-878-5305 MOORESVILLE 704-664-5281

IMPROVEMENT PERMIT / CERTIFICATE OF COMPLETION / OPERATION PERMIT / EXISTING SYSTEM INSPECTION

PROPERTY DESCRIPTION NO. ~~27655~~ C62220 DATE 7-5-96 TAX MAP NO. 8P-A-68 Pt 06 Watershed: ☐ Yes ☐ No

OWNER OR CONTRACTOR James C. Henline JR. PHONE: Business _____ Home 876 0259 WSIV

ADDRESS 2408 Chipley Ford Rd Statesville N.C.

LOCATION I-40 W TR Sharon School TL Islands Ford 1 mi Rt

SUBDIVISION _____ BLOCK / SECTION _____ LOT _____ LOT AREA 2.138 acres SITE CLASS. PS DESIGN FLOW 360 L.T.A.R. .13

Septic Tank: 1000 Gallons; STB 1012 Date 4-7-97

Pump Tank: _____ Gallons; PT _____ Date _____

Pump Make: _____ Model _____ Serial No. _____

Nitrification Field: No Fields 1 Square Feet 1200 Linear Feet 400

No Lines 3 Trench Width 36" Max Trench Bottom Depth 36" Gravel Depth 12"

☑ New System ☐ Repair System Type: I, II, III, IV, V, VI

System Description: Conv. Gravity

Repair System Description: " "

Maintenance Agreement Required: ☐ Yes ☐ No

☑ House/Mod. Home No. Bedrooms 3

☐ Mobile Home No. Bathrooms 2½

☐ Business No. Employees _____


☐ Other _____

☐ Slab ☐ Crawl Space ☐ Basement w/plumbing ☐ Basement wo/plumbing

Water Supply: ☑ Individual ☐ Community ☐ Public


Comments: 30' 333'

INITIAL SITE SKETCH

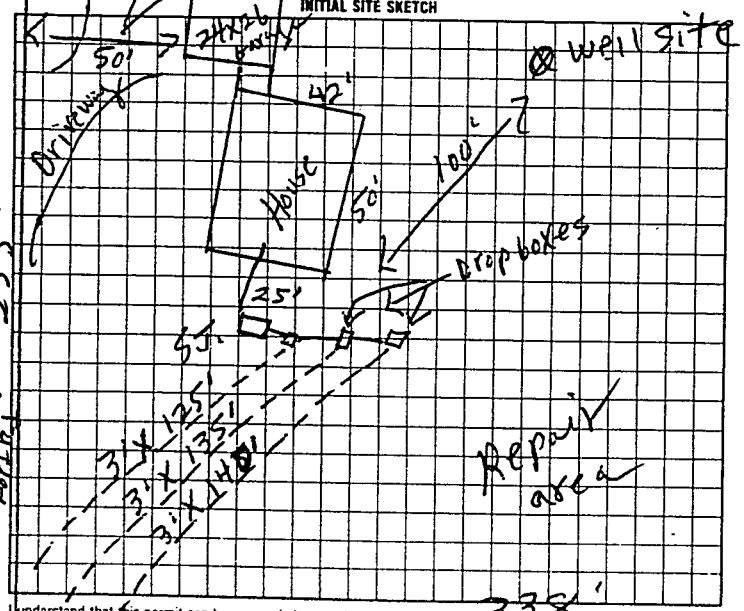

Comments:

AS BUILT SKETCH

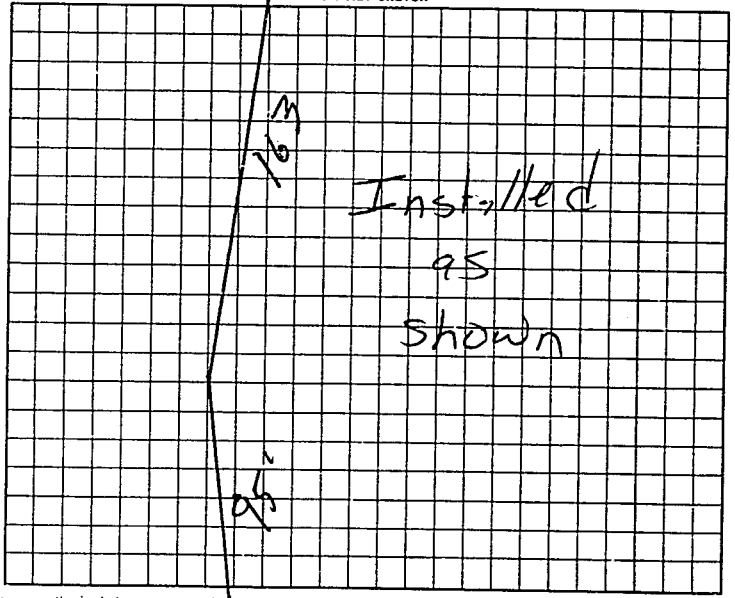

I understand that this permit can be suspended or revoked if any false information is supplied toward securing the permit/any unauthorized changes are made to the site/any unauthorized changes are made in the installation of the system.

Signed: James C Henline Jr

Improvement Permit by: J.C. moore date 7-5-96

Existing System Inspection by: ~~Authorization~~ J.C. moore date 7-5-96

Installed by: Forest Shuford

Certificate of Completion by: _____ date _____

Operation Permit by Mary C Ott IO date 6-5-97

+ to court.

HEALTH DEPT COPY WHITE INSPECTION COPY (FINAL) GREEN OWNER COPY (FINAL) YELLOW INSPECTION COPY (INITIAL) PINK (OWNER COPY (INITIAL) GOLD

Authorization to court EXPIRES 60 mos FROM ISSUE