This Permit void Permit issued 2-23-98

IREDELL COUNTY HEALTH DEPARTMENT

STATESVILLE 704-878-5305 MOORESVILLE 704-664-5281

IMPROVEMENT PERMIT / AUTHORIZATION TO CONSTRUCT / OPERATION PERMIT / EXISTING SYSTEM INSPECTION

PERMIT# 071997 PIN# 3784421115 DATE 2-27-98

OWNER OR CONTRACTOR Lydia Bustle PHONE: Business Home 835-1936

ADDRESS 1790 Old Lion Rd Statesville

LOCATION I-40 TR Sharon Sch TL Island Ford TR Old Lion lot on (E)

SUBDIVISION BLOCK / SECTION LOT LOT AREA 0.73ac SITE CLASS. P/S DESIGN FLOW 360 L.T.A.R. 0.3

Septic Tank: 1000 Gallons; STB 620 Date 5-19-98

Pump Tank: Gallons; PT Date

Pump Make: Model Serial No.

Nitrification Field: No Fields 1 Square Feet Linear Feet 400

No Lines 3 Trench Width 36in Max Trench Bottom Depth 36in Gravel Depth

[X] New System [ ] Repair System Type: I, [II], III, IV, V, VI

System Description: Gravity Conventional

Repair System Description: no Panels

Maintenance Agreement Required: [ ] Yes [X] No

[ ] House/Mod. Home No. Bedrooms 3

[X] Mobile Home No. Bathrooms 2

[ ] Business No. Employees

[ ] Other

[ ] Slab [X] Crawl Space [ ] Basement w/plumbing [ ] Basement wo/plumbing


Water Supply: [X] Individual [ ] Public [ ] Community

Comments:/Conditions:


Comments:/Conditions:

Note: Chambers installed instead of gravel enough for 4 Bds - slightly deeper trench

INITIAL SITE SKETCH 166

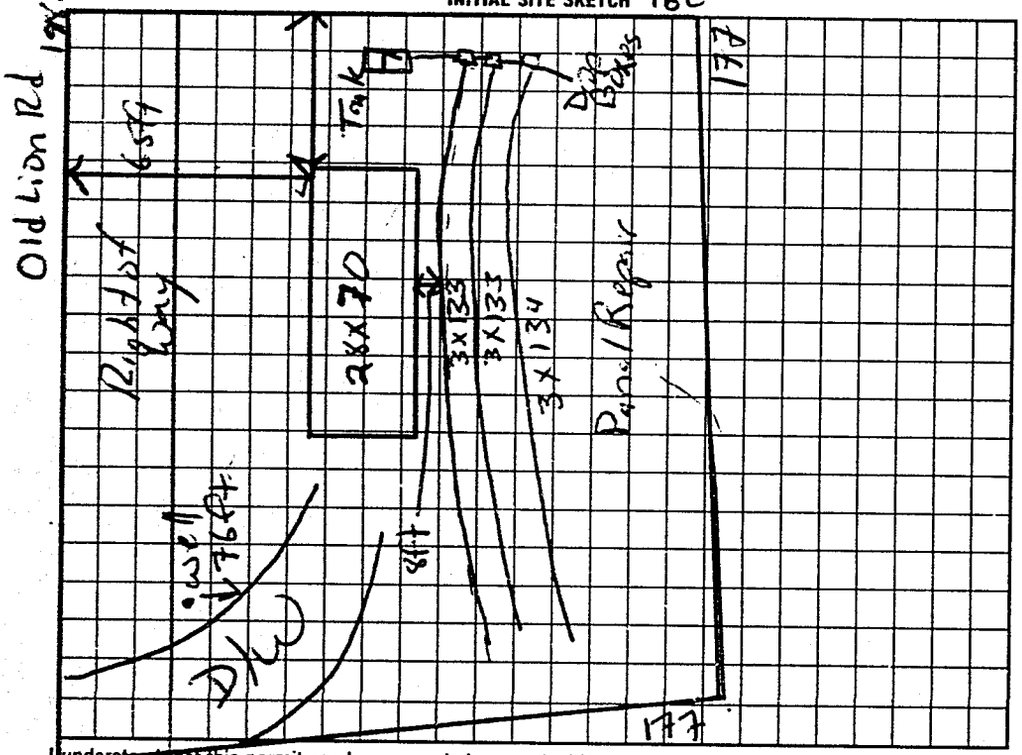

AS BUILT SKETCH

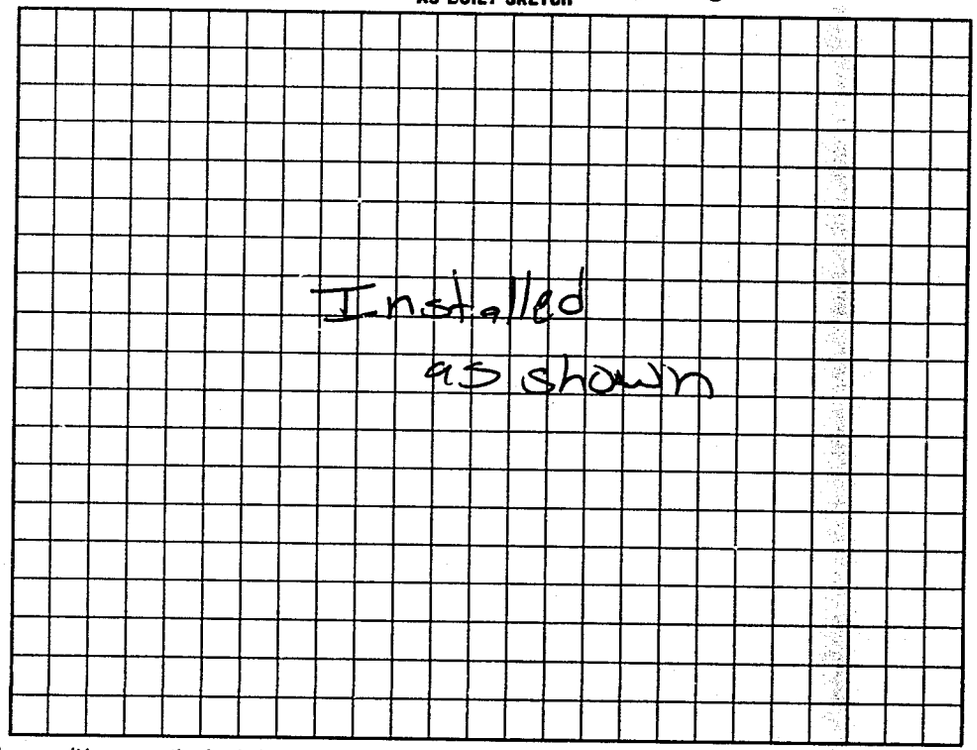

I understand that this permit can be suspended or revoked if any false information is supplied toward securing the permit/any unauthorized changes are made to the site/any unauthorized changes are made in the installation of the system. Improvement Permit with plat valid without expiration. Improvement Permit with site plan valid for sixty months. Authorization to Construct is valid for a period equal to that of Improvement Permit – not to exceed sixty months.

Signed: date 5/1/98 Installed by: Keith Pate

Improvement Permit by: Mark C Oates RS date 2-27-98 Operation Permit by: Mark C Oates RS date 6-2-98

Authorization to Construct by: Mark C Oates RS date 2-27-98 Existing System Inspection by: date

HEALTH DEPT. COPY: WHITE INSPECTION COPY (FINAL): GREEN OWNER COPY (FINAL): YELLOW INSPECTION COPY (INITIAL): PINK OWNER COPY (INITIAL): GOLD