63473

# IREDELL COUNTY HEALTH DEPARTMENT

STATESVILLE 704-878-5305 MOORESVILLE 704-664-5281

## IMPROVEMENT PERMIT / CERTIFICATE OF COMPLETION / OPERATION PERMIT / EXISTING SYSTEM INSPECTION

PROPERTY DESCRIPTION NO. 23971 DATE 10-11-96 TAX MAP NO. 8P-A-22D Watershed: ☐ Yes ☐ No

OWNER OR CONTRACTOR Scott Freeland PHONE: Business Home 872-5195 Yadkin PA

ADDRESS 220 West Iredell circle Statesville

LOCATION I-40 W TR Sharon School TL Island Ford TR old Fire 4th lot Rt

SUBDIVISION BLOCK / SECTION LOT LOT AREA 209X424 SITE CLASS. 125 DESIGN FLOW 360 L.T.A.R. 13

Septic Tank: 1000 Gallons; STB 825 Date 8-1-96
Pump Tank: Gallons; PT Date
Pump Make: Model Serial No.
Nitrification Field: No Fields 1 Square Feet 1200 Linear Feet 400
No Lines 4 Trench Width 36" Max Trench Bottom Depth 36" Gravel Depth 12"

☑ New System ☐ Repair System Type: I, II, III, IV, V, VI
System Description: Conv. Gravity
Repair System Description: " "
Maintenance Agreement Required: ☐ Yes ☑ No


☐ House/Mod. Home No. Bedrooms 3
☑ Mobile Home No. Bathrooms 2
☐ Business No. Employees
☐ Other
☐ Slab ☑ Crawl Space ☐ Basement w/plumbing ☐ Basement wo/plumbing

Water Supply: ☑ Individual ☐ Community ☐ Public


Comments: Replaces lay-out made 7-23-96 For Ronald Browning 424

Comments:

INITIAL SITE SKETCH

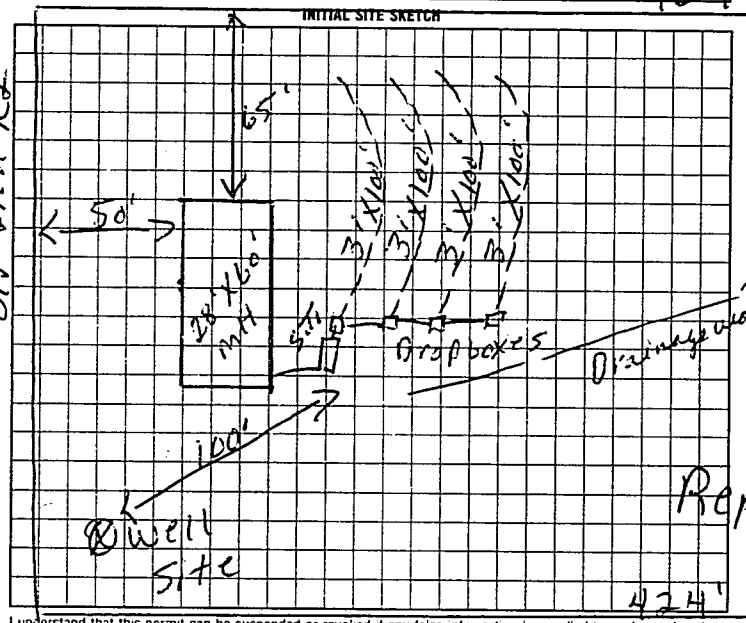


AS-BUILT SKETCH

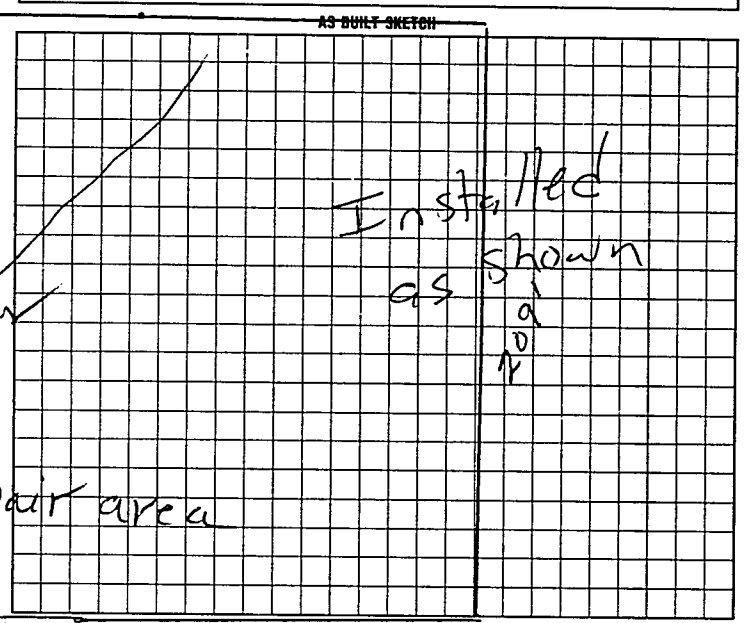


I understand that this permit can be suspended or revoked if any false information is supplied toward securing the permit/any unauthorized changes are made to the site/any unauthorized changes are made in the installation of the system.

Signed: X Scott Freeland

Improvement Permit by: F. C. Moore date 10-11-96

Existing System Inspected by: Authorization F. C. Moore date 10-11-96

Installed by: Rowan Septic tank

Certificate of Completion by: date

Operation Permit by: Mark COA PS date 10-16-96

to Court Telephone Region to Court Expired to Environmental Health

HEALTH DEPT. COPY: WHITE INSPECTION COPY (FINAL): GREEN OWNER COPY (FINAL): YELLOW INSPECTION COPY (INITIAL): PINK OWNER COPY (INITIAL): GOLD