IREDELL COUNTY HEALTH DEPARTMENT

Statesville Office (704) 878-5305 Mooresville Office (704) 660-3625 PERMIT # 216891

IMPROVEMENT PERMIT / AUTHORIZATION TO CONSTRUCT / OPERATION PERMIT / EXISTING SYSTEM

PIN # 3784429508

APPLICANT: Mark Collins APPLICANT ADDRESS: 415 New Sterling Rd.

SITE ADDRESS: 128 Old Lion Rd. PHONE: 704-902-3816 ALT. PHONE: N/A

SITE DIRECTIONS: I-40 W to Sharon School Rd TL Island Ford Rd TR Old Lion Rd.


SUBDIVISION: N/A SECTION: N/A LOT # N/A LOT AREA: 1.55 acres DESIGN FLOW: 360gpd L.T.A.R.: 0.275

Septic Tank	1000 (gal)	STB	1012-1000	Date	3-7-16	☑ New System ☐ Repair ☐ Expansion	System Type: I II (III) IV V VI	☑ Residence	No. Bedrooms 3
Pump Tank	(gal)	PT		Date		System Description:	25% Reduction	☐ Business	No. Persons 6
Pump Make	Model			Serial #		Repair System Description:	50% Reduction	☐ Other	No. Employees
# Nitrification Fields	1	# Lines	3	Linear Ft:	325'	Maintenance Agreement Required:	☐ YES ☑ NO	☐ Slab	☑ Crawl Space
Trench Width	36"	Max. Trench Bottom Depth	27" high side	Gravel Depth	N/A	☑ GRAVITY	☐ PRESSURE	☐ Basement w/plumbing	☐ Basement w/o plumbing


Water Supply: ☑ Private ☐ Public ☐ Community

Comments / Conditions: IMPROVEMENTS ONLY! Submit floor Plan prior to issuance of CA! Install a 25% Reduction system on contour with serial distribution.

INITIAL SITE SKETCH

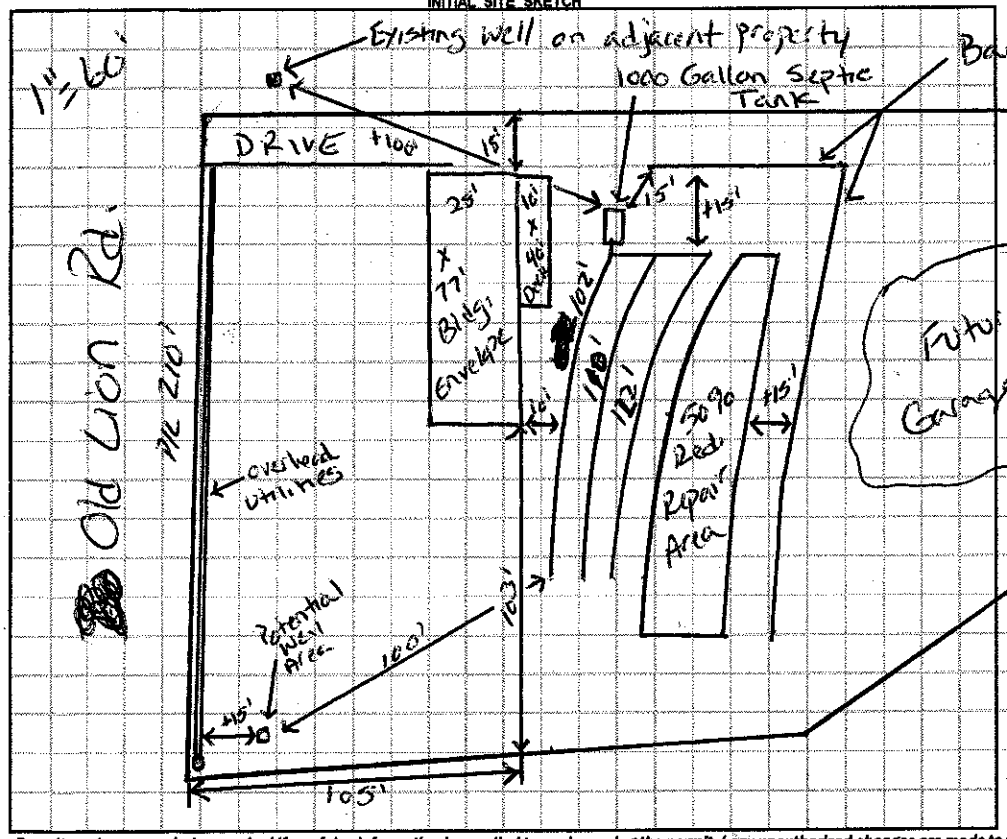

AS BUILT SKETCH

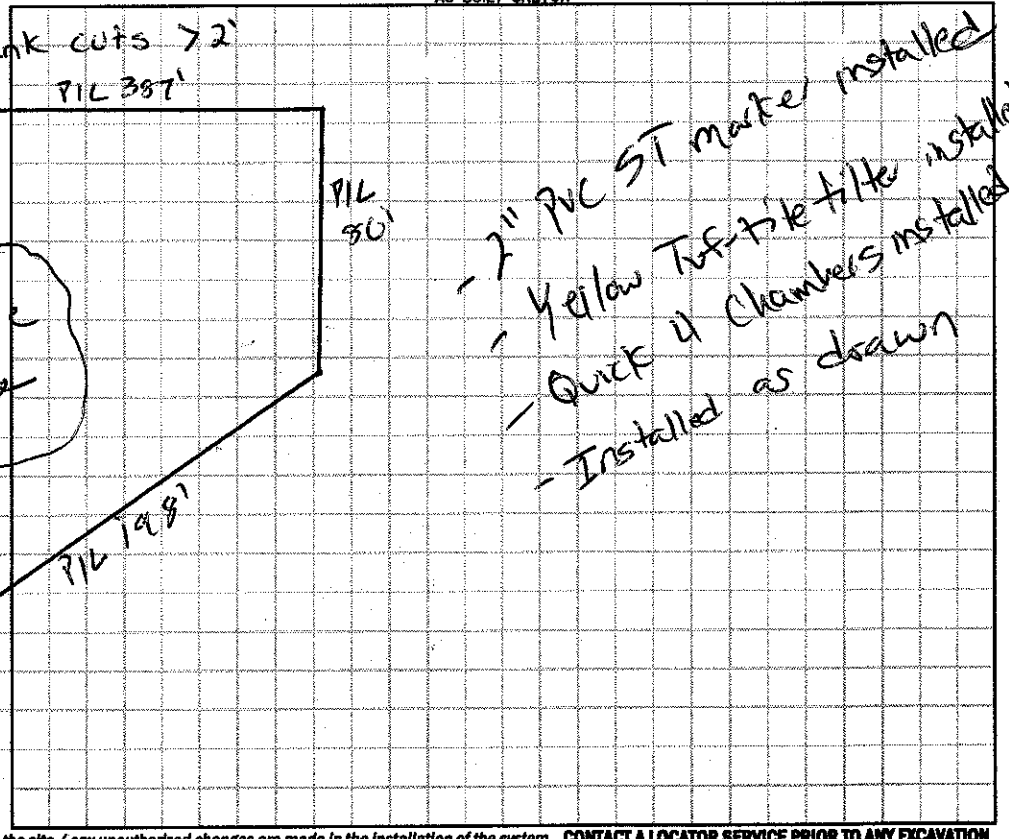

Permit can be suspended or revoked if any false information is supplied toward securing the permit / any unauthorized changes are made to the site / any unauthorized changes are made in the installation of the system. **CONTACT A LOCATOR SERVICE PRIOR TO ANY EXCAVATION**

☐ **IMPROVEMENT PERMIT** *with plat valid without expiration.* ☑ **IMPROVEMENT PERMIT** *with site plan valid for 60 mos.* ☑ **AUTHORIZATION TO CONSTRUCT** *valid for period equal to IMPROVEMENT PERMIT--not to exceed 60 mo.*

Owner / Applicant Signature: Kimberly Sanders Date: 2-29-16 Installed by: Tommy Frye

IMPROVEMENT PERMIT by: Justin Henderson Date: 2-2-16 OPERATION PERMIT by: Justin Henderson Date: 6-7-16

AUTHORIZATION TO CONSTRUCT by: Justin Henderson Date: 2-11-16 Existing System Inspected by: Date:

Health Dept. Copy - WHITE Applicant (Final Approval) - YELLOW Applicant (Conditional Approval) - PINK