IREDELL COUNTY HEALTH DEPARTMENT

STATESVILLE 704-878-5305 MOORESVILLE 704-664-5281

IMPROVEMENT PERMIT / CERTIFICATE OF COMPLETION / OPERATION PERMIT / EXISTING SYSTEM INSPECTION

PROPERTY DESCRIPTION NO. 06992 72494 DATE 11-7-97 TAX MAP NO. 3784 43 6224 (PT) Watershed: ☐ Yes ☑ No

OWNER OR CONTRACTOR CHRISTINA LANTZ PHONE: Business Home

ADDRESS 3010 21ST LN NE, HICKORY, NC 28601

LOCATION I-40 W, TR SHARON SCHOOL, TL ISLAND FORD, TR BRADY WOODS, AT END STRAIGHT AHEAD.

SUBDIVISION BLOCK / SECTION LOT LOT AREA ~5.5 ACRES SITE CLASS: PS DESIGN FLOW 360 L.T.A.R. 0.30 GPD/FT2

Septic Tank: 1000 Gallons; STB 1012 Date 12-5-97

Pump Tank: Gallons; PT Date

Pump Make: Model Serial No.

Nitrification Field: No. Fields 1 Square Feet 1200 Linear Feet 400

No. Lines FOUR Trench Width 36" Max Trench Bottom Depth 36" Gravel Depth 12"

☑ New System ☐ Repair System Type: I, (II), III, IV, V, VI

System Description: CONVENTIONAL GRAVITY

Repair System Description: CONV. GRAVITY

Maintenance Agreement Required: ☐ Yes ☑ No

☐ House/Mod. Home ☑ Mobile Home ☐ Business ☐ Other

No. Bedrooms 3 No. Bathrooms 2 No. Employees


☐ Slab ☑ Crawl Space ☐ Basement w/plumbing ☐ Basement wo/plumbing

Water Supply: ☑ Individual ☐ Community ☐ Public WELL

Comments: KEEP SYSTEM MINIMUM 100' FROM WELL

Comments: well / House Not on site at time of inspection

INITIAL SITE SKETCH SCALE: 1"=50'

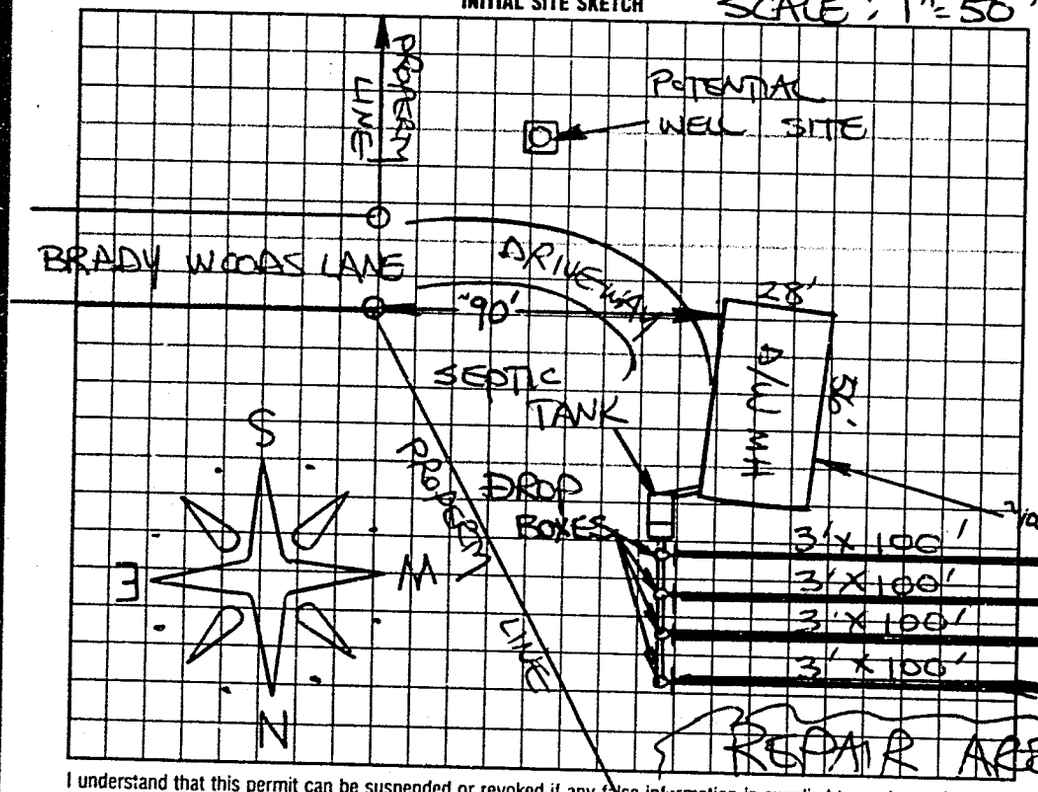

AS BUILT SKETCH

Installed as shown

I understand that this permit can be suspended or revoked if any false information is supplied toward securing the permit/any unauthorized changes are made to the site/any unauthorized changes are made in the installation of the system. Improvement Permit is valid for 60 months from date of issuance. AUTHORIZATION TO CONSTRUCT IS VALID FOR 60 MONTHS FROM DATE OF ISSUANCE.

Signed: Christina Lantz

Improvement Permit by: STEVE HEDRICK date 11-7-97

Auth. To Const. ~~Existing System Inspection~~ by: STEVE HEDRICK date 11-7-97

Installed by: Steve Jordan

~~Certificate of Completion~~ by: date

Operation Permit by: Mark Caudle date 3-6-98

HEALTH DEPT. COPY: WHITE INSPECTION COPY (FINAL): GREEN OWNER COPY (FINAL): YELLOW INSPECTION COPY (INITIAL): PINK OWNER COPY (INITIAL): GOLD