IREDELL COUNTY HEALTH DEPARTMENT

STATESVILLE 704-878-5305 MOORESVILLE 704-664-5281

IMPROVEMENT PERMIT / CERTIFICATE OF COMPLETION / OPERATION PERMIT / EXISTING SYSTEM INSPECTION

PROPERTY DESCRIPTION NO. 67252 DATE 7-1-97 TAX MAP NO. 3784 43 6224 Watershed: ☐ Yes ☒ No

OWNER OR CONTRACTOR Michelle Ann Brady PHONE: Business _____ Home 704 466-2124 WSIV CA

ADDRESS 1667 Cessna Lane Conover N.C.

LOCATION I-40 TR Sharon School TL Island Ford Rd TR Rt before old Lion Rt on Private Rd

SUBDIVISION _____ BLOCK / SECTION _____ LOT _____ LOT AREA 3.32 acres SITE CLASS PS DESIGN FLOW 480 L.T.A.R. .135

Septic Tank: 1000 Gallons; STB 1012 Date 8-29-97

Pump Tank: _____ Gallons; PT _____ Date _____

Pump Make: _____ Model _____ Serial No. _____

Nitrification Field: No Fields 1 Square Feet 1380 Linear Feet 460

No Lines 4 Trench Width 36" Max Trench Bottom Depth 36" Gravel Depth 12"

☐ New System ☐ Repair System Type: I ☒ III, IV, V, VI

System Description: Conv. Gravity

Repair System Description: " "

Maintenance Agreement Required: ☐ Yes ☒ No

☐ House/Mod. Home ☒ Mobile Home ☐ Business ☐ Other

No. Bedrooms 3 No. Bathrooms 2 No. Employees _____

☐ Slab ☒ Crawl Space ☐ Basement w/plumbing ☐ Basement wo/plumbing


Water Supply: ☒ Individual ☐ Community ☐ Public

Comments:

Comments:

* Note first two lines deeping ground

INITIAL SITE SKETCH

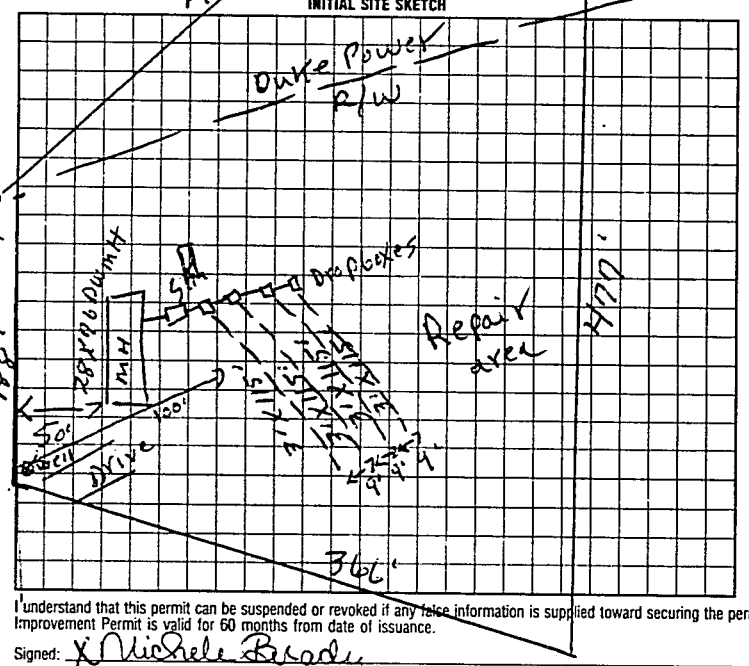

AS BUILT SKETCH

* Installed as shown

I understand that this permit can be suspended or revoked if any false information is supplied toward securing the permit/any unauthorized changes are made to the site/any unauthorized changes are made in the installation of the system. Improvement Permit is valid for 60 months from date of issuance.

Signed: X Michele Brady

Improvement Permit by: P.C. Moore date 7-1-97

Existing System Authorization by: P.C. Moore date 7-1-97

authorization to count.

Installed by: Bakers Landscaping

Certificate of Completion by: _____ date _____

Operation Permit by: Mat C.O.P. RS date 11-17-97

HEALTH DEPT. COPY: WHITE INSPECTION COPY (FINAL): GREEN OWNER COPY (FINAL): YELLOW INSPECTION COPY (INITIAL): PINK OWNER COPY (INITIAL): GOLD

authorization to count. Expires 60 mos from issue

791800