**IREDELL COUNTY HEALTH DEPARTMENT - *ENVIRONMENTAL HEALTH*** ☒ STATESVILLE OFFICE 704-878-5305 ☐ MOORESVILLE OFFICE 704-664-5281

**IMPROVEMENT PERMIT / AUTHORIZATION TO CONSTRUCT / OPERATION PERMIT / EXISTING SYSTEM INSPECTION**

PERMIT # 171468 PIN # 3784455849 DATE 5-7-12

OWNER Sara + Greg Waugh APPLICANT: SAME PHONE: Home/Cell # 704-902-0908 (Alford) Business #

SITE ADDRESS 1151 Sharon School Rd. OWNER / APPLICANT ADDRESS

SITE DIRECTIONS I-40 West to Sharon School, North on Sharon School ~ 3 miles on left

SUBDIVISION n/a BLOCK / SECTION n/a LOT # n/a LOT AREA 16.204 DESIGN FLOW 480 L.T.A.R. .3

Septic Tank 1000 Gallons: STB 1012 Date 6-4-12 ☒ New System ☐ Repair ☐ Expansion System Type I (II) III IV V VI ☒ Residence No. Bedrooms 4 Water Supply

Pump Tank Gallons: P T Date System Description: 25% Reduction Gravity ☐ Business No. Persons ☒ Private


Pump Make Model Serial # Repair System Description: 25% Reduction Gravity ☐ Other No. Employees ☐ Public

No. Nitrification Fields: 1 No. Lines 4 Linear Feet 400 Maintenance Agreement Required ☐ YES ☒ NO ☐ Slab ☐ Crawl Space ☐ Community


Trench Width 36" Max. Trench Bottom Depth 36" Gravel Depth n/a ☒ GRAVITY ☐ PRESSURE ☒ Basement w/plumbing ☐ Basement w/o plumbing

Comments / Conditions

INITIAL SITE SKETCH

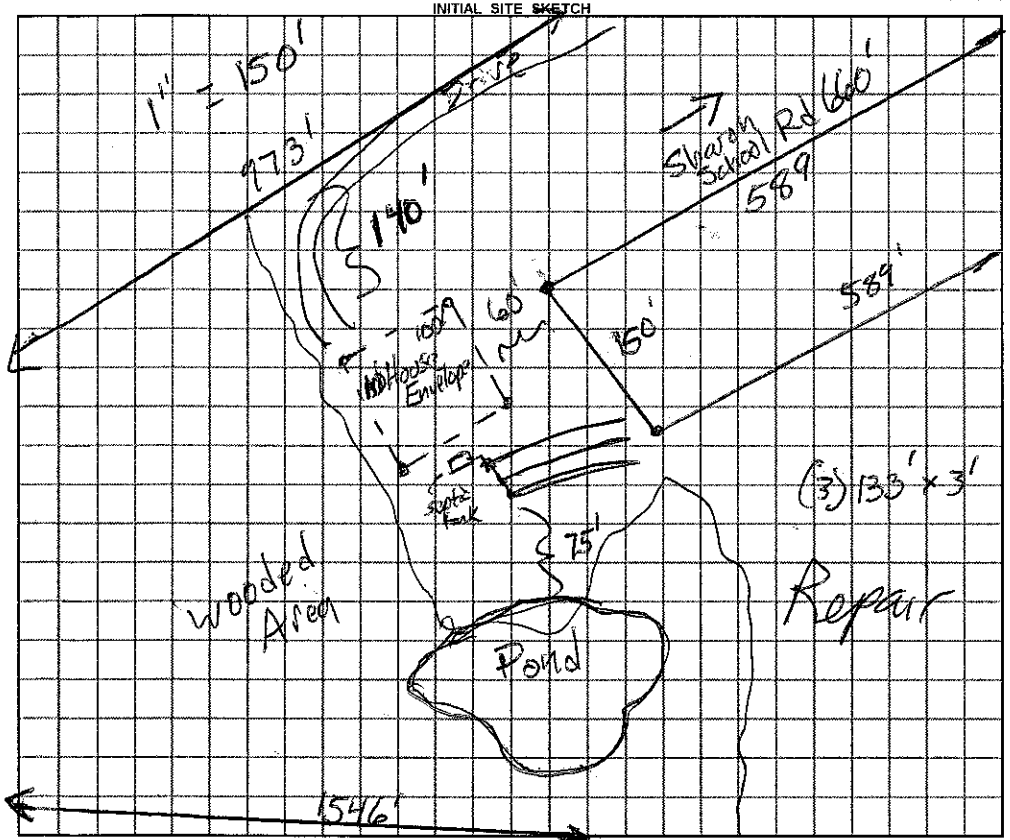


AS BUILT SKETCH

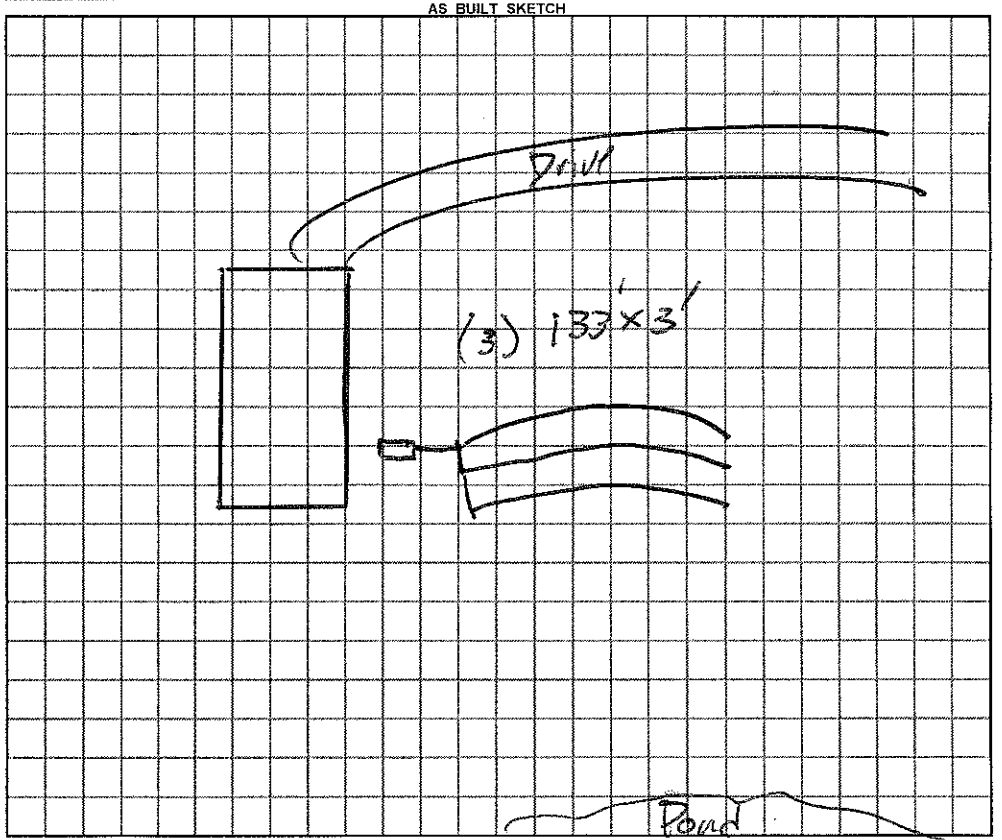


*Permit can be suspended or revoked if any false information is supplied toward securing the permit / any unauthorized changes are made to the site / any unauthorized changes are made in the installation of the system.*

☐ ***IMPROVEMENT PERMIT*** with plat valid without expiration. ☒ ***IMPROVEMENT PERMIT*** with plat valid without expiration. site plan valid 60 mo. ☐ ***AUTHORIZATION TO CONSTRUCT*** valid for period equal to IMPROVEMENT PERMIT--not to exceed 60 mo.

Owner / Applicant Signature: Sara Waugh Date

IMPROVEMENT PERMIT by: James REHS Date 5-7-12

AUTHORIZATION TO CONSTRUCT by: James REHS Date 5-14-12

***YOU SHOULD CONTACT A LOCATOR SERVICE PRIOR TO ANY EXCAVATION***

Installed by: Yount Grading

OPERATION PERMIT by: James REHS Date 4-18-13

Existing System Inspected by: REHS Date

White Copy – Environmental Health YELLOW COPY (Final) Owner / Applicant PINK COPY (Initial) Owner / Applicant