12069.

IREDELL COUNTY HEALTH DEPARTMENT

(SEPTIC TANK) IMPROVEMENTS PERMIT AND CERTIFICATE OF COMPLETION

(Ground Absorption Sewage Disposal System -- G. S. Chapter 130-Article 13C)

OWNER OR CONTRACTOR FRED CHAPMAN DATE 10-10-90 PERMIT NO. SP-A-140.

PHONE: Business _____ Home _____

LOCATION Lot #10 W-T Rogers Storage Subd. Rd. - approx. one mile past Shannondale Country Club - mobile home left - brick house. S. R. No. _____

SUBDIVISION NAME _____ LOT NO. _____ SECTION OR BLOCK NO. _____

House ( ) Mobile Home (✓) Business ( ) Other _____

No. Bedrooms 3 No. Bathrooms 2

Garbage Disposal Unit Yes ( ) No (✓)

Auto. Dishwasher Yes ( ) No (✓)

Auto. Wash. Machine Yes (✓) No ( )

Site Suitable Yes (✓) No ( )

Lot Area 2 acres.

Character & Porosity of Soils Loam Suitable.

Percolation Rate 2-120 min/in.

Topography 2-10%

Depth to Water Table 10'+

Rock or other impervious formations scattered rock.

_____ Basement with Plumbing _____ Basement without Plumbing ✓ No Basement

Size of Tank 1000 Gals.

Nitrification Field:


No. of Lines 3

Sq. Ft. 720 Lineal Ft. 240

Depth of Stone in Lines 12"

Water Supply: Individual (✓)

Public ( )

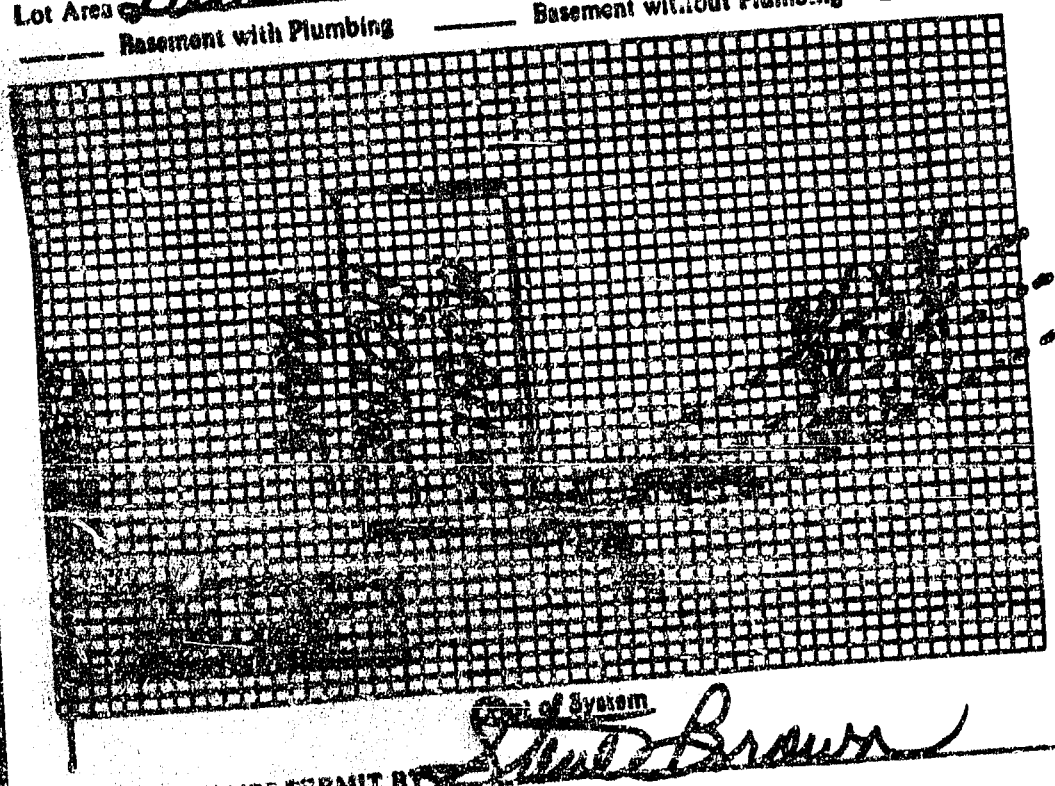

Installed by Dennis Gallihar

I understand and agree to install septic tank system as specified on this Improvements Permit.

Signed: _____

Plan of System

IMPROVEMENTS PERMIT BY Steve Brown

COMMENTS: _____

CERTIFICATE OF COMPLETION BY Steve Brown DATE 10-10-90.

EXISTING SYSTEM CHECKED BY: _____ DATE _____

CONSTRUCTION MUST COMPLY WITH ALL OTHER APPLICABLE STATE AND LOCAL REGULATIONS.

Permit is VOID if any unauthorized changes are made in installation of system and/or if any false information is supplied in making Improvements Permit.

Health Dept. Copy: White Inspection Dept. Copy: Yellow Sanitarian's Copy: Pink Owner's Copy: Gold