IREDELL COUNTY HEALTH DEPARTMENT

STATESVILLE 704-878-5305 MOORESVILLE 704-664-5281

IMPROVEMENT PERMIT / CERTIFICATE OF COMPLETION / OPERATION PERMIT / EXISTING SYSTEM INSPECTION

PROPERTY DESCRIPTION NO. 22379 DATE 11-7-95 TAX MAP NO. 8P-A-141 Watershed: ☐ Yes ☑ No

OWNER OR CONTRACTOR FRED CHADMAN, JR PHONE: Business Home 873-9052

ADDRESS 1201 SHARON SCHOOL ROAD, STATESVILLE, NC 28677

LOCATION I-40 W, TR SHARON SCHOOL RD, TL KIMBERLY LANE, 1ST LOT ON RIGHT (BEHIND HOUSE)

SUBDIVISION BLOCK / SECTION LOT LOT AREA ½ ACRES SITE CLASS. #5 DESIGN FLOW 240 L.T.A.R. 0.3 GPD/FT²

Septic Tank: 1000 Gallons; STB 1012 Date 8-19-95

Pump Tank: Gallons; PT Date

Pump Make: Model Serial No.

Nitrification Field: No Fields 1 Square Feet 810 Linear Feet 270

No Lines 4 Trench Width 36 Max Trench Bottom Depth 18-36" Gravel Depth 12"

☑ New System ☐ Repair System Type: I, II, III, IV, V, VI

System Description: CONVENTIONAL GRAVITY

Repair System Description: CONVENTIONAL PUMP

Maintenance Agreement Required: ☐ Yes ☑ No

☐ House/Mod. Home No. Bedrooms 2

☑ Mobile Home No. Bathrooms 1

☐ Business No. Employees

☐ Other


☐ Slab ☑ Crawl Space ☐ Basement w/plumbing ☐ Basement wo/plumbing

Water Supply: ☐ Individual ☐ Community ☐ Public WELL


Comments:

Comments: SYSTEM INSTALLED SLIGHTLY OUT OF CONTOUR DUE TO INSTALLERS CHANGE OF SYSTEM LAYOUT

INITIAL SITE SKETCH

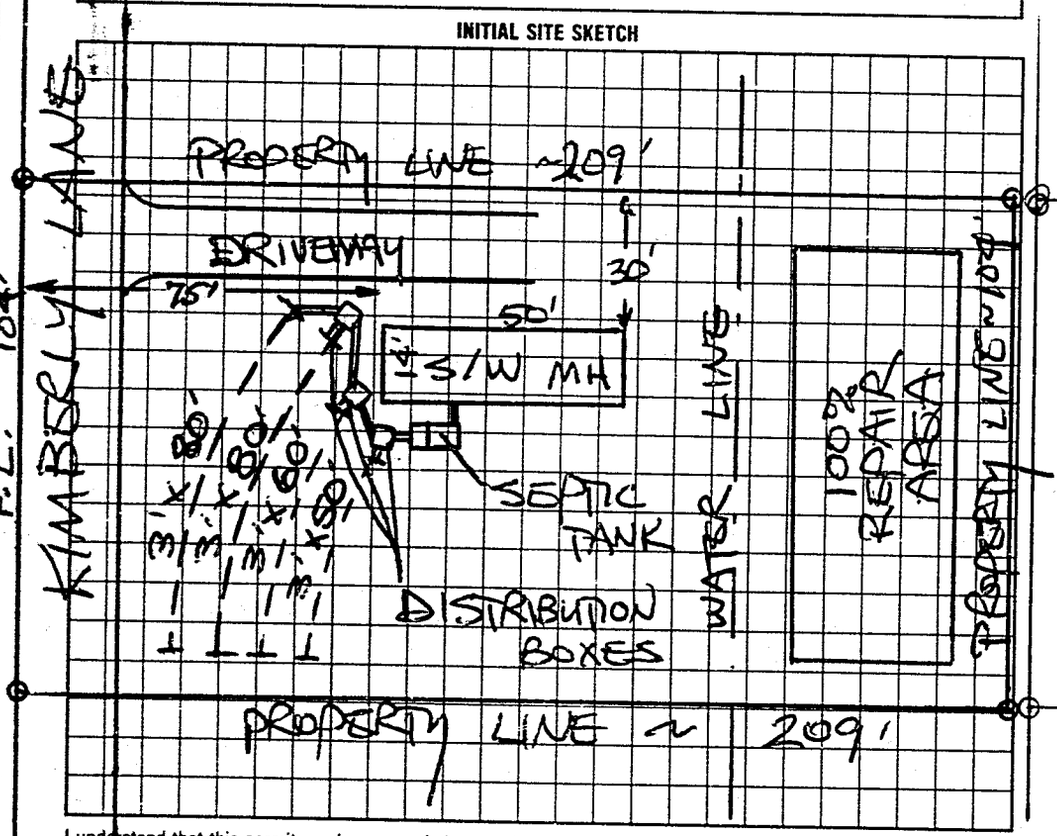

AS BUILT SKETCH

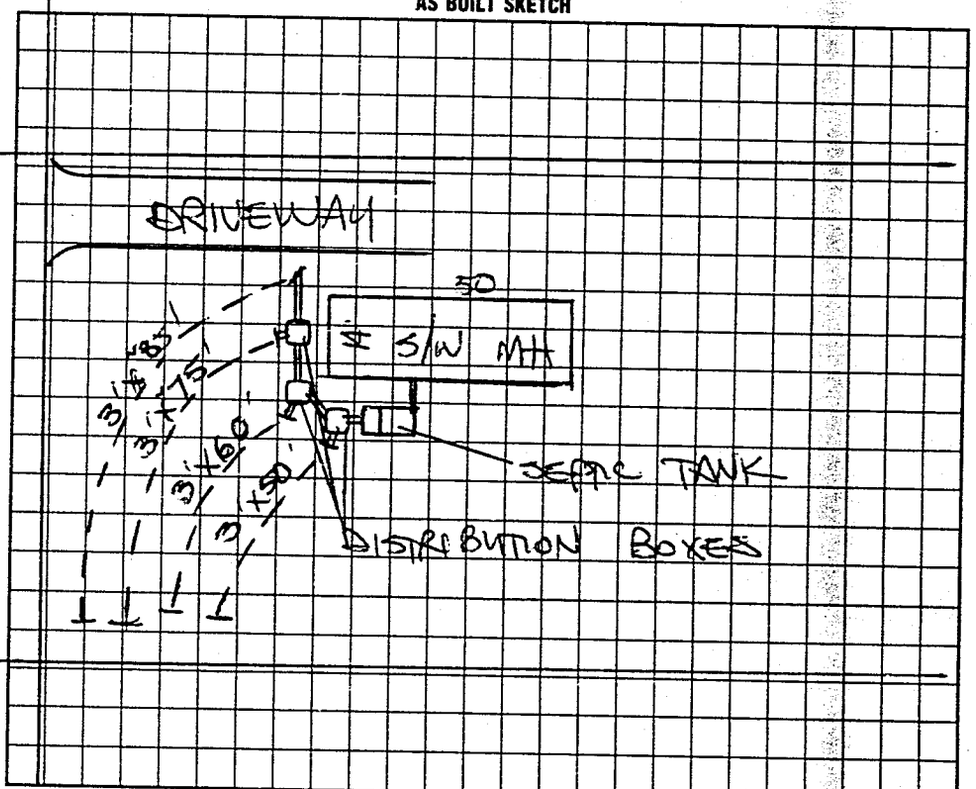

I understand that this permit can be suspended or revoked if any false information is supplied toward securing the permit/any unauthorized changes are made to the site/any unauthorized changes are made in the installation of the system.

AUTHORIZATION TO CONSTRUCT IS VALID FIVE (5) YEARS FROM DATE OF ISSUANCE. IMPROVEMENT PERMIT HAS NO EXPIRATION DATE.

Signed: Fred Chapman

Improvement Permit by: STEVE HEDRICK date 11-7-95

~~Authorization to Construct~~ ~~Existing System Inspection~~ by: STEVE HEDRICK date 11-7-95

Installed by: DONALD LACKEY

~~Certificate of Completion by:~~ date

Operation Permit by STEVE HEDRICK date 11-16-95

HEALTH DEPT COPY WHITE INSPECTION COPY (FINAL) GREEN OWNER COPY (FINAL) YELLOW INSPECTION COPY (INITIAL) PINK OWNER COPY (INITIAL) GOLD