07945

IREDELL COUNTY HEALTH DEPARTMENT

(SEPTIC TANK) IMPROVEMENTS PERMIT AND CERTIFICATE OF COMPLETION
(Ground Absorption Sewage Disposal System -- G. S. Chapter 130-Article 13C)

OWNER OR CONTRACTOR DONNA FORBES DATE 2-1-89 PERMIT NO. 13A

PHONE: Business _____ Home _____

LOCATION Hwy 21 - T.R. on Hoover Schofield - T.L. on Lee Hunt Dam Rd. Across from Hoover Systems Lot - 1st house on left - Rock Hill Rd

S. R. No. _____

SUBDIVISION NAME _____ LOT NO. _____ SECTION OR BLOCK NO. _____

House (✓) Mobile Home ( ) Business ( ) Other _____

No. Bedrooms 3 No. Bathrooms 2.5

Garbage Disposal Unit Yes ( ) No (✓)

Auto. Dishwasher Yes (✓) No ( )

Auto. Wash. Machine Yes (✓) No ( )

Site Suitable Yes (✓) No ( )

Lot Area 87.77 acres

Character & Porosity of Soil Clay, Suitable


Percolation Rate Good

Topography Rolling

Depth to Water Table 24"

Rock or other impervious formations None observed

_____ Basement with Plumbing ✓ Basement without Plumbing _____ No Basement

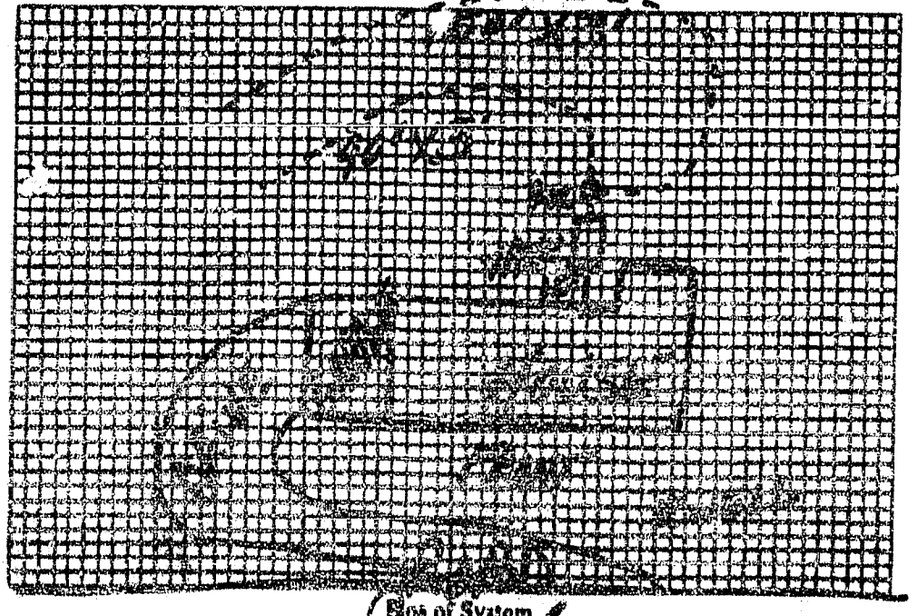

Size of Tank 1000 Gals.

Nitrification Field:

No. of Lines 2

Sq. Ft. 225 Linear Ft. 240

Depth of Stone in Lines 12"

Water Supply: Individual (✓)
Public ( )

Installed by Jacob Hubbs

I understand and agree to install septic tank system as specified on this Improvements Permit.

Signed: _____

Plan of System

IMPROVEMENTS PERMIT BY Steve Brown

COMMENTS: _____

CERTIFICATE OF COMPLETION BY Steve Brown DATE 2-1-89

EXISTING SYSTEM CHECKED BY: _____ DATE _____

CONSTRUCTION MUST COMPLY WITH ALL OTHER APPLICABLE STATE AND LOCAL REGULATIONS.

Permit is VOID if any unauthorized changes are made in installation of system and/or if any false information is supplied in making Improvements Permit.

Health Dept. Copy: White Inspection Dept. Copy: Yellow Sanitarian's Copy: Pink Owner's Copy: Gold