Voids Permit Issued 4-7-99

IREDELL COUNTY HEALTH DEPARTMENT

STATESVILLE 704-878-5305 MOORESVILLE 704-664-5281

IMPROVEMENT PERMIT / AUTHORIZATION TO CONSTRUCT / OPERATION PERMIT / EXISTING SYSTEM INSPECTION

PERMIT# 80323 PIN# 3784537468 DATE 4-13-99

OWNER OR CONTRACTOR Rebecca McHargo PHONE: Business 872-7739 Home

ADDRESS 166 Benfield Rd Statesville

LOCATION Sharon School Rd on left ½ mile past Sharon Market

SUBDIVISION BLOCK / SECTION LOT LOT AREA 2.2 AC SITE CLASS PS DESIGN FLOW 360 L.T.A.R. .3

Septic Tank: 1000 Gallons; STB 1012 Date 6-1-99

Pump Tank: Gallons; PT Date

Pump Make: Model Serial No.

Nitrification Field: No Fields 1 Square Feet 1200 Linear Feet 400

No Lines 5 Trench Width 36" Max Trench Bottom Depth 36" Gravel Depth 12"

[X] New System [ ] Repair System Type: I. II. III. IV. V. VI

System Description: Gravity Conv.

Repair System Description: Pump Conv.

Maintenance Agreement Required: [ ] Yes [X] No

[X] House/Mod. Home No. Bedrooms 3

[ ] Mobile Home No. Bathrooms 2

[ ] Business No. Employees

[ ] Other


[ ] Slab [X] Crawl Space [ ] Basement w/plumbing [ ] Basement wo/plumbing

Water Supply: [X] Individual [ ] Public [ ] Community WELL


Comments/Conditions: Install Lines on Contour
Keep system 100ft from any wells. Keep first 4 lines 15ft from Road ditch
Possible Pump Repair Area

Comments/Conditions: VOID Permit Issued on 4-7-99

INITIAL SITE SKETCH

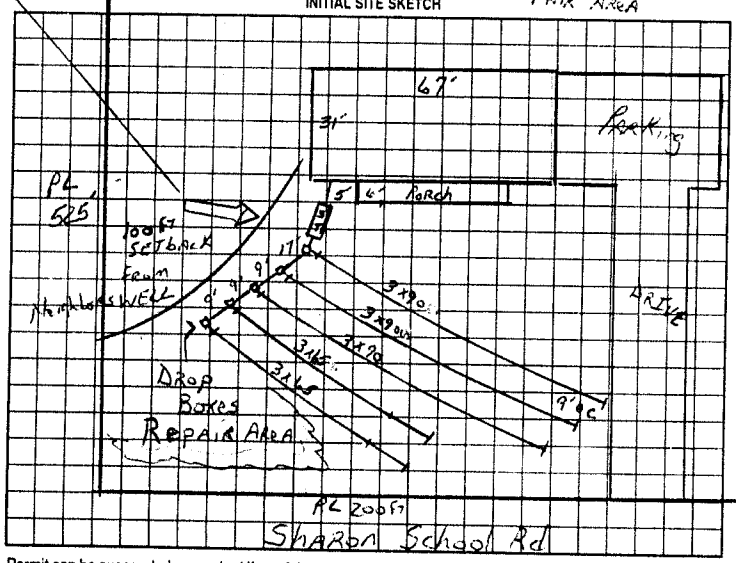

AS BUILT SKETCH

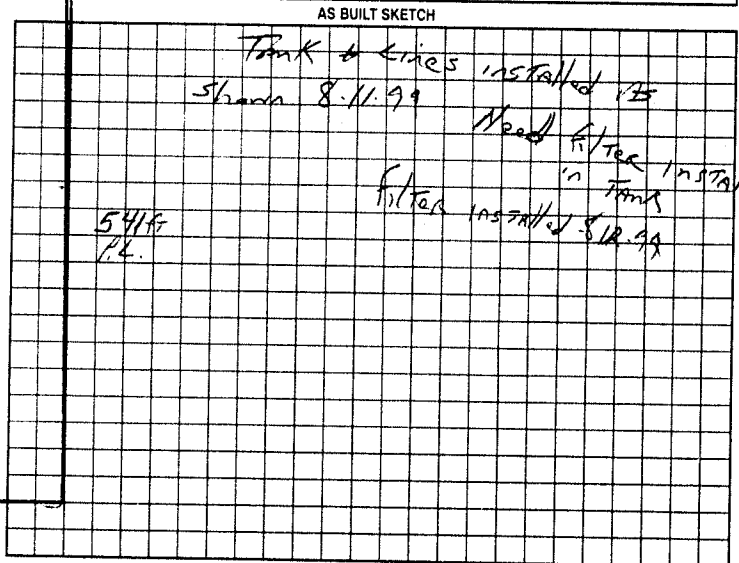

Permit can be suspended or revoked if any false information is supplied toward securing the permit/any unauthorized changes are made to the site/any unauthorized changes are made in the installation of the system. Improvement Permit with plat valid without expiration. Improvement Permit with site plan valid for sixty months. Authorization to Construct is valid for a period equal to that of Improvement Permit – not to exceed sixty months.

Signed: Owner Marhan date 6-1-99

Improvement Permit by: L. Potter date 4-13-99

Authorization to Construct by: L. Potter date 4-13-99

Installed by: R Kearney Madison

Operation Permit by: L. Potter date 8-12-99

Existing System Inspection by: date

HEALTH DEPT. COPY WHITE OWNER COPY (FINAL) YELLOW OWNER COPY (INITIAL) PINK