IREDELL COUNTY HEALTH DEPARTMENT

STATESVILLE 704-878-5305 MOORESVILLE 704-664-5281

IMPROVEMENT PERMIT / AUTHORIZATION TO CONSTRUCT / OPERATION PERMIT / EXISTING SYSTEM INSPECTION

PERMIT # Repair PIN # 3784-54-5821 DATE 19 February 09

OWNER or APPLICANT Bill & Lynn Gagg PHONE: Business Home: 704-872-6786

OWNER or APPLICANT ADDRESS 1073 Sharon School Rd. Statesville

LOCATION / DIRECTIONS I40 W TR Sharon School Rd. 2nd L on left.

SUBDIVISION BLOCK / SECTION LOT # LOT AREA 2 Ac. DESIGN FLOW 360 gpd L.T.A.R. 0.3 / 1.1

Septic Tank 1000 Gallons: STB 760 Date 6-19-08
Pump Tank Gallons: P T Date
Pump Make Model Serial #
Nitrification Field No Fields 1 No Lines 5 Linear Feet 300
Trench Width 36" Max. Trench Bottom Depth 36" Gravel Depth NA

☐ New System ☑ Repair ☐ Expansion System Type I II III IV V VI
System Description: 25% Reduction
Repair System Description:
Maintenance Agreement Required ☐ YES ☑ NO
☑ GRAVITY ☐ PRESSURE

☑ Residence No. Bedrooms 3
☐ Business No. Persons
☐ Other No. Employees
☐ Slab ☐ Crawl Space
☑ Basement w/plumbing ☐ Basement w/o plumbing


Water Supply: ☑ Private ☐ Public ☐ Community

Comments / Conditions
* Keep 50' from all wells.
* Replace old septic tank / Keep 15'+ from pool

Comments / Conditions

INITIAL SITE SKETCH

AS BUILT SKETCH

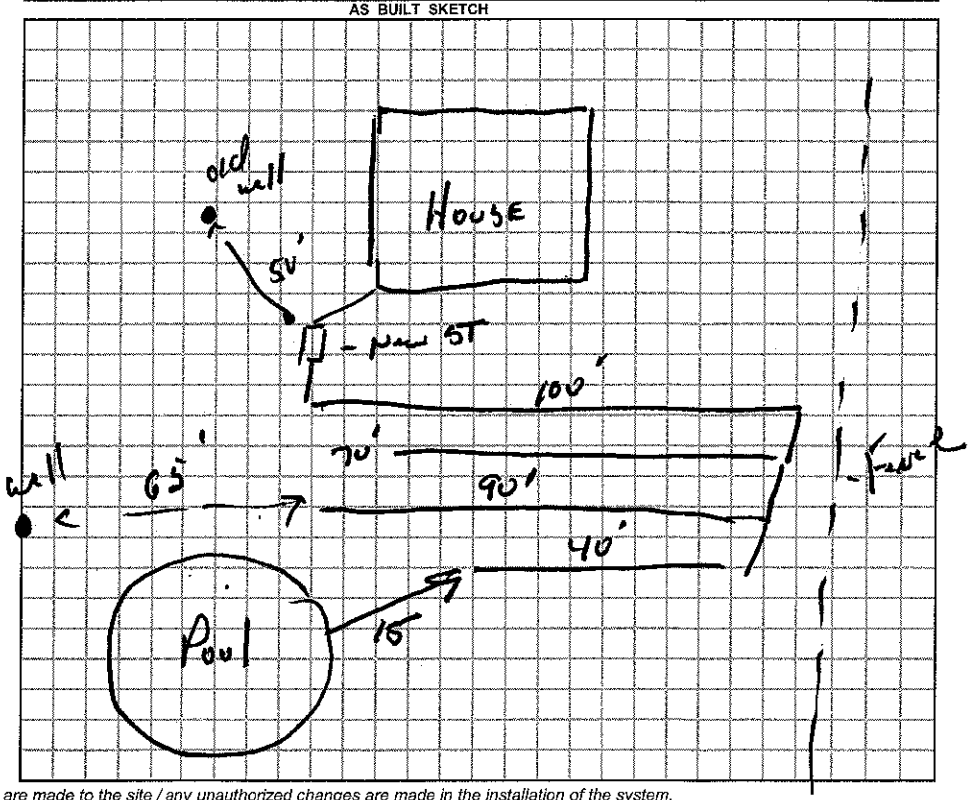

Permit can be suspended or revoked if any false information is supplied toward securing the permit / any unauthorized changes are made to the site / any unauthorized changes are made in the installation of the system.

☐ *IMPROVEMENT PERMIT w / plat valid without expiration* ☑ *IMPROVEMENT PERMIT w / site plan valid for 60 mos.* ☑ *AUTHORIZATION TO CONSTRUCT valid for period equal to IMPROVEMENT PERMIT-not to exceed 60 mo.*

Owner / Applicant Signature: Lynn Gagg Date 2/19/09

Improvement Permit by: R.S. Date 19 Feb. 09

Authorization to Construct by: R.S. Date 19 Feb. 09

YOU SHOULD CONTACT A LOCATOR SERVICE PRIOR TO ANY EXCAVATION.

Installed by: A-1

Operation Permit by: Date: 11 March 09

Existing System Inspected by: Date:

WHITE COPY Environmental Health YELLOW COPY (Final) Owner / Applicant PINK COPY (Initial) Owner / Applicant