IREDELL COUNTY HEALTH DEPARTMENT

STATESVILLE 704-878-5305 MOORESVILLE 704-664-5281

IMPROVEMENT PERMIT / AUTHORIZATION TO CONSTRUCT / OPERATION PERMIT / EXISTING SYSTEM INSPECTION

PERMIT# REPAIR PIN# 3784-63-0974 DATE 7-13-07

OWNER OR APPLICANT RYAN SENG CHA PHONE: Business Home 704-924-8205

ADDRESS 1025 SHARON SCHOOL ROAD, STATESVILLE, NC 28625

LOCATION I-40 WEST, TR SHARON SCHOOL ROAD, ON LEFT 0.1 MILE PAST NEW STERLING ROAD AT #1025

SUBDIVISION BLOCK / SECTION LOT LOT AREA 2.82 ACRES SITE CLASS. PS DESIGN FLOW 360 L.T.A.R. 0.30 GPD/FT²

Septic Tank: EXISTING Gallons; STB Date

Pump Tank: Gallons; PT Date

Pump Make: Model EQ. TO 1200 Serial No.

Nitrification Field: No Fields 1 Square Feet Linear Feet 300

No Lines THREE Trench Width 36" Max Trench Bottom Depth 36"

☐ New System ☑ Repair ☐ Expansion System Type: I II III IV V VI

System Description:

Repair System Description: 25% REDUCTION, CAT IV

Maintenance Agreement Required: ☐ Yes ☑ No

☑ House/Mod. Home No. Bedrooms 3

☐ Mobile Home No. Persons

☐ Business No. Employees

☐ Other


Water Supply: ☑ Individual ☐ Public ☐ Community WELL

Gravity ☐ Pressure ☐ Slab ☐ Crawl Space ☑ Basement w/plumbing ☐ Basement wo/plumbing

Comments/Conditions: ① INSTALL NEW SANITARY TEE IN SEPTIC TANK AS NECESSARY ② INSTALL 25% REDUCTION SYSTEM ON CONTOUR AS SHOWN ③ SYSTEM TO BE REPAIRED BY AUGUST 13, 2007

Comments/Conditions: New Tee installed.

INITIAL SITE SKETCH

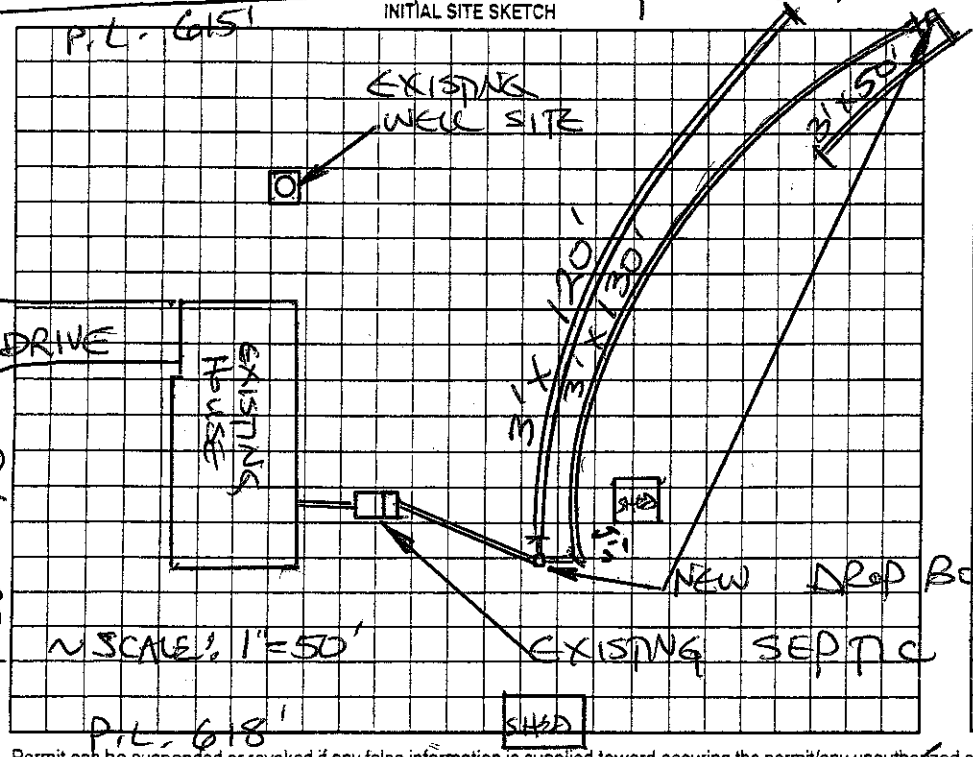

AS BUILT SKETCH

Installed as Drawn.

Permit can be suspended or revoked if any false information is supplied toward securing the permit/any unauthorized changes are made to the site/any unauthorized changes are made in the installation of the system. Improvement Permit with plat valid without expiration ☐ Improvement Permit with site plan valid for sixty months ☑ Authorization to Construct is valid for a period equal to that of Improvement Permit – not to exceed sixty months.

Signed: Ryan Seng Cha date 7-13-07 Installed by: Steve Jordan

Improvement Permit by: STEVE HEDRICK date 7-13-07 Operation Permit by: P.E. date 7/24/07

Authorization to Construct by: STEVE HEDRICK date 7-13-07 Existing System Inspection by: date

HEALTH DEPT. COPY: WHITE OWNER COPY (FINAL): YELLOW OWNER COPY (INITIAL): PINK