47280

IREDELL COUNTY HEALTH DEPARTMENT

STATESVILLE 704-878-5305 MOORESVILLE 704-664-5281

IMPROVEMENT PERMIT / CERTIFICATE OF COMPLETION / OPERATION PERMIT / EXISTING SYSTEM INSPECTION

PROPERTY DESCRIPTION NO 1630 DATE 1-20-94 TAX MAP NO. 89-A-10

OWNER OR CONTRACTOR Harold Dagenhart PHONE Business Home 873-8048 Watershed: ☐ Yes ☑ No

ADDRESS

LOCATION 240W TR Sharon Sch. Rd. TR County Line Rd TR Balick Rd. TR Dirt Rd Lot at end of Rd.

SUBDIVISION NA BLOCK / SECTION NA LOT — LOT AREA 4.7 acres SITE CLASS P.S DESIGN FLOW 360 L.T.A.R. 36 gpd / ft²

Septic Tank 1000 Gallons STA 1012 Date 11-5-93

Pump Tank — Gallons — Date —

Pump Make — Model — Serial No —

Nitrification Field No. 1 Square Feet 1035 Linear Feet 345

No Lines 1 Width 36" Bottom Depth 36" Gravel Depth 12" ☐ Slab ☑ Crawl Space ☐ Basement w/plumbing ☐ Basement w/o plumbing

☑ New System ☐ Repair System Type I (II III IV V)

System Description conventional / gravity fed

Repair System Description

Maintenance Agreement Required: ☐ Yes ☑ No

☑ House/Mod. Home No. Bedrooms 3

☐ Mobile Home No. Bathrooms 3

☐ Business No. Employees

☐ Other


Water Supply: ☑ Individual ☐ Community ☐ Public

Comments:

Comments: System installed deeper than permitted due to House foundation being lower than what was placed here Also well location different than planned for, this also altered system installation. 100% Repair below system, conventional / gravity fed.

INITIAL SITE SKETCH

AS BUILT SKETCH

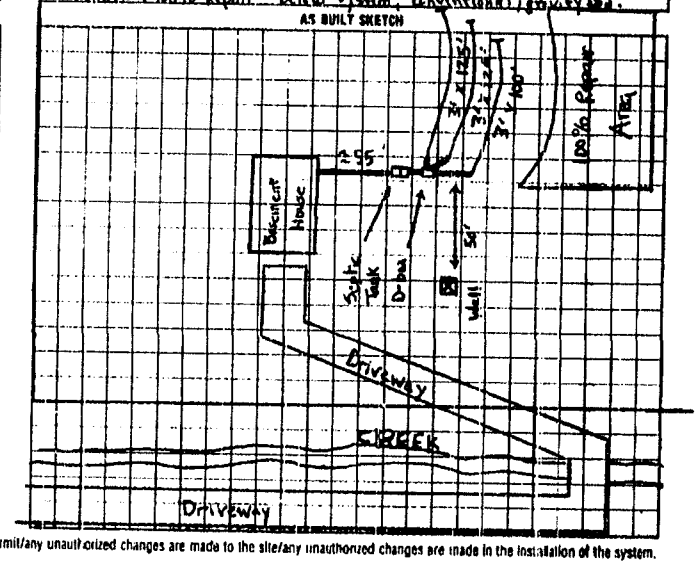

I understand that this permit can be suspended or revoked if any false information is supplied toward securing the permit/any unauthorized changes are made to the site/any unauthorized changes are made in the installation of the system. Improvement Permit is valid for 60 months from date of issuance

Signed:

Improvement Permit by Michael J. Dawson date 5-6-93

Existing System Inspection by date

Installed by: Tommy Catherer

Certificate of Completion by: Michael J. Dawson date 1-21-94

Operation Permit by date

JAN. 3, 1989 0:30