# IREDELL COUNTY HEALTH DEPARTMENT

STATESVILLE 704-878-5305 MOORESVILLE 704-664-5281

Existing System

## IMPROVEMENT PERMIT / AUTHORIZATION TO CONSTRUCT / OPERATION PERMIT / EXISTING SYSTEM INSPECTION

PERMIT# 97824 PIN# 3784 684413 DATE Feb 17 2000

OWNER OR CONTRACTOR Harold Dingenhart PHONE: Business Home 583 9888

ADDRESS left

LOCATION I40 W Sharon School N (R) County Line (R) Rollie Rd (R) Wild Rabbit Lane (DIRT) follow to end bear 360

SUBDIVISION BLOCK / SECTION LOT LOT AREA 4.7 Ac SITE CLASS P5 DESIGN FLOW R5 L.T.A.R. 35/M. Dennis "93

Septic Tank: 1000 existing Gallons; STB 1012 Date 11-5-93
Pump Tank: Gallons; PT Date
Pump Make: Model Serial No.
Nitrification Field: No Fields 1 Square Feet 1035 Linear Feet 345 Sq Ft
No Lines 3 Trench Width 36" Max Trench Bottom Depth Gravel Depth 12"

☐ New System ☐ Repair System Type: I. II. III. IV. V. VI
System Description: Conv. Gravity
Repair System Description: Same
Maintenance Agreement Required: ☐ Yes ☒ No

☒ House/Mod. Home No. Bedrooms 3
☐ Mobile Home No. Bathrooms 3
☐ Business No. Employees
☐ Other

☐ Slab ☐ Crawl Space ☒ Basement w/plumbing ☐ Basement wo/plumbing


Water Supply: ☒ Individual ☐ Public ☐ Community
well

Comments:/Conditions: Re-Original Permit: System installed deeper than orgiral design called for Due To foundation being lower.

Comments:/Conditions: 2-17 No Sep of System Failure
Adding Top Floor To basement home

INITIAL SITE SKETCH

AS BUILT SKETCH

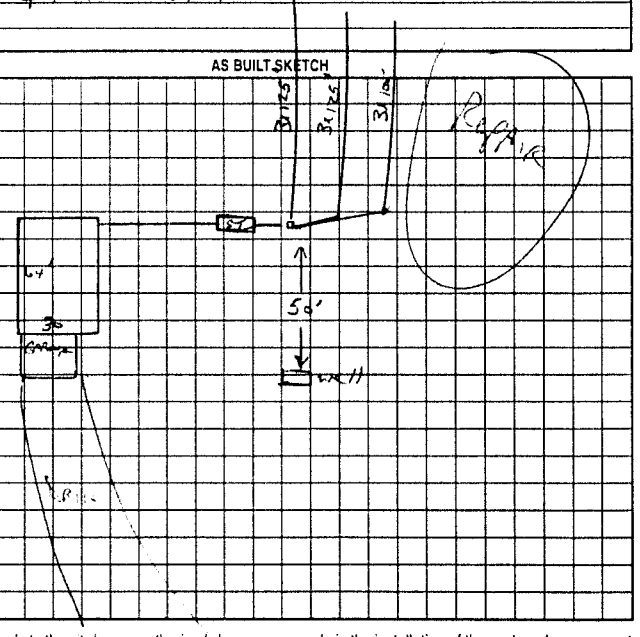


Permit can be suspended or revoked if any false information is supplied toward securing the permit/any unauthorized changes are made to the site/any unauthorized changes are made in the installation of the system. Improvement Permit with plat valid without expiration. Improvement Permit with site plan valid for sixty months. Authorization to Construct is valid for a period equal to that of Improvement Permit – not to exceed sixty months.

Signed: date Installed by: T. Cothren

Improvement Permit by: date Operation Permit by: date

Authorization to Construct by: date Existing System Inspection by: J. C. Potter date Feb 17 2000

HEALTH DEPT. COPY: WHITE OWNER COPY (FINAL): YELLOW OWNER COPY (INITIAL): PINK